

**SURVEY & REMONUMENTATION**

FEB 14 1997

COMMISSION

**LAND CORNER RECORDATION CERTIFICATE**  
**Filing Requirement of Act 74, Mich. P.A. 1970**

KENT COUNTY REMONUMENTATION

For corners in

Kent (County)	Located in:	Gaines Township	Corner Code #
1 Public Land Survey	T <u>5N</u>	R <u>11W</u>	<u>E-1</u>
	T _____	R _____	_____
	T _____	R _____	_____
	T _____	R _____	_____
2 Property Controlling in Section	S _____	T _____	R _____
	S _____	T _____	R _____
3 Miscellaneous Property in Sec.	S _____	T _____	R _____
	S _____	T _____	R _____


STATE OF MICHIGAN  
 COUNTY OF KENT  
 RECEIVED FOR RECORD

95 AUG -8 AM 8:42

REG. OF DEEDS  
*Lucy St...*  
**9241**

Register of Deeds Stamp & File Number

4 Lot No. \_\_\_\_\_, Recorded Plat \_\_\_\_\_  
 5 Private Claims \_\_\_\_\_

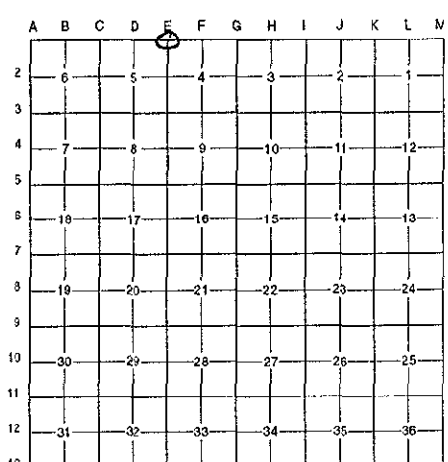

I, Randy Kolehouse, in a field survey on January 3 19 96, do hereby certify that under requirements of P.A. 74 Michigan P.A. of 1970, the corner points mentioned in lines 1 and 2 above were in conformance with regulations and rules therefore as required in the current manual of survey instructions of the United States Department of the interior, Bureau of Land Management or by a decree of a Court of Law and/or that the corner points mentioned in lines 3, 4 and 5 above were in conformance with the rules of the Michigan Board of Land Surveyors or by a Decree of a Court of Law; established, re-established, monumented, re-monumented, recovered, found as expressed below:

**NOTE: Not more than 4 corners, all in the same town and range, may be recorded on this certificate.**

A Description of original monument and accessories and/or subsequent restoration:

E-1	1831	G.L.O. Notes	Mullett	Set Post
	1965	Witness Map	K.C. Monument	Iron in Monument Box
	1976	L.C.R.C. #1296	Exxel Engineering	Iron in Monument Box
	1983	L.C.R.C. #3470	William Byl	Fnd. Iron in Mon. Box / Set K.C. Monument
	1985	L.C.R.C. #4295	Williams & Works	K.C. Monument
	1992	L.C.R.C. #6545	J. Bueche	K.C. Monument

P.A. 345 1990 KENT COUNTY  
 PEER APPROVED 3/2/96  
 CHAIRMAN Randy Kolehouse

Note: This corner is not common with E-13, T6N, R11W.  
 This corner was originally approved by the Kent County Remonumentation Peer Group and monumented by William Byl on 7/21/83 and was recorded per L.C.R.C. #3470.

B Description of corner evidence found and/or method applied in restoring or reestablishing corner:

E-1 Found a Standard Kent County Monument at the C/L intersection of 60th Street (bit.) running E & W and Kalamazoo Avenue (bit.) running N & S, 11.76' East of E-13, T6N, R11W, per L.C.R.C.'s #3470, #4295 and #6545, as set by William Byl in place of a 1-1/4" iron in a monument box which checks L.C.R.C. #1296 and K.C. Surveyor's records.

L.C.R.C. #3470	L.C.R.C. #4295	L.C.R.C. #6545
SE cor. Sec. 32, 6-11 (Kent Co. Mon.) W 11.78'	C/L SW side of 10" dia. Mich. Con. Gas vent S 45° E 68.08' SE corner Sec. 32, T6N, R11W (Kent County Harrison Mon. in mon. box) W 11.78'	Nail in E side PP S 17° W 191.10' (m. 190.70') SE cor. conc. for sign N 45° W 109.13' (m. 109.12') SE brick for sign S 40° W 92.74' (m. 92.72') N & E edge of walk N 35° E 59.05' (m. 59.06') C/L SW side 10" dia. MICHCON Gas vent S 45° E 68.06' (m. 68.06') Top C/L hydr. N 30° W 94.98' (m. 94.95') K.C. Mon. SE cor. 32, 5-11 W 11.78' (m. 11.76')

The selected location is accepted by me and is generally accepted by professional surveyors as the best available evidence of the position of the original corner.

C Description of monument for corner and accessories established to perpetuate locating the position of the corner:

E-1 Standard Kent County Monument

Nail & K.C. remon. tag on E side P. pole S 17° W 190.70'	Int. N & E edge walk N 35° E 59.06'
East cor. brick sign S 40° W 92.72'	C/L SW side 10" dia. Michcon Gas Vent S 45° E 68.06'
South cor. conc. base for sign N 48° W 109.12'	K.C. Mon. SE cor. 32, T6N, R11W, West 11.76'
C/L top hydrant N 30° W 94.95'	

Signed by Randy J. Kolehouse Date 7/23/96  
 EARTH TECH  
 Surveyor's Michigan License No. 25854

