

**SURVEY & REMONUMENTATION**

FEB 14 1997

COMMISSION

**LAND CORNER RECORDATION CERTIFICATE**  
**Filing Requirement of Act 74, Mich. P.A. 1970**  
**KENT COUNTY REMONUMENTATION**

For corners in

Kent (County)	Located in:	Gaines Township	Corner Code #
1. Public Land Survey	T <u>5N</u>	R <u>11W</u>	<u>E-3</u>
	T _____	R _____	_____
	T _____	R _____	_____
	T _____	R _____	_____
2. Property Controlling in Section	S _____	T _____	R _____
	S _____	T _____	R _____
3. Miscellaneous Property in Sec.	S _____	T _____	R _____
	S _____	T _____	R _____

4. Lot No. \_\_\_\_\_, Recorded Plat \_\_\_\_\_  
 5. Private Claims \_\_\_\_\_

STATE OF MICHIGAN  
 COUNTY OF KENT  
 RECEIVED FOR RECORD

96 AUG - 8 AM 8:42

REG. OF DEEDS  
 9243


Register of Deeds Stamp & File Number

I, Randy Kolehouse, in a field survey on January 2 19 96, do hereby certify that under requirements of P.A. 74 Michigan P.A. of 1970, the corner points mentioned in lines 1 and 2 above were in conformance with regulations and rules therefore as required in the current manual of survey instructions of the United States Department of the Interior, Bureau of Land Management or by a decree of a Court of Law and/or that the corner points mentioned in lines 3, 4 and 5 above were in conformance with the rules of the Michigan Board of Land Surveyors or by a Decree of a Court of Law; established, re-established, monumented, re-monumented, recovered, found as expressed below:

NOTE: Not more than 4 corners, all in the same town and range, may be recorded on this certificate.

A. Description of original monument and accessories and/or subsequent restoration:

E-3	1831	G.L.O. Notes	Mullett	Set Post
	1973 <td>L.C.R.C. #413 <td>K.C. Surveyor <td>Iron in Mon. Box</td> </td></td>	L.C.R.C. #413 <td>K.C. Surveyor <td>Iron in Mon. Box</td> </td>	K.C. Surveyor <td>Iron in Mon. Box</td>	Iron in Mon. Box
	1981 <td>L.C.R.C. #2286 <td>Medema, Van Kooten &amp; Assoc. <td>3/4" Iron in Mon. Box</td> </td></td>	L.C.R.C. #2286 <td>Medema, Van Kooten &amp; Assoc. <td>3/4" Iron in Mon. Box</td> </td>	Medema, Van Kooten & Assoc. <td>3/4" Iron in Mon. Box</td>	3/4" Iron in Mon. Box
	1988 <td>L.C.R.C. #4905 <td>Nederveld &amp; Associates <td>Fnd. 3/4" Iron in Mon. Box / Set K.C. Monument</td> </td></td>	L.C.R.C. #4905 <td>Nederveld &amp; Associates <td>Fnd. 3/4" Iron in Mon. Box / Set K.C. Monument</td> </td>	Nederveld & Associates <td>Fnd. 3/4" Iron in Mon. Box / Set K.C. Monument</td>	Fnd. 3/4" Iron in Mon. Box / Set K.C. Monument
	1989 <td>L.C.R.C. #5033 <td>Chris Marschall <td>Reset K.C. Monument</td> </td></td>	L.C.R.C. #5033 <td>Chris Marschall <td>Reset K.C. Monument</td> </td>	Chris Marschall <td>Reset K.C. Monument</td>	Reset K.C. Monument
			J. Bueche	K.C. Monument

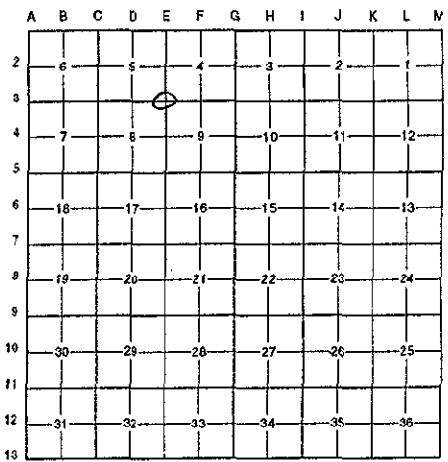

P.A. 345 1990 KENT COUNTY  
 PEER APPROVED 3/7/96  
 CHAIRMAN Randy Kolehouse

This corner was originally approved by the Kent County Remonumentation Peer Group and monumented by Nederveld & Associates on 8/18/81 and was recorded per L.C.R.C. #2286.

B. Description of corner evidence found and/or method applied in restoring or reestablishing corner:

E-3 Found a Standard Kent County Monument in the C/L intersection of 68th Street (bit.) running E & W and Kalamazoo Avenue (bit.) running N & S per L.C.R.C.'s #4905 and #5033 as reset by Chris Marschall using L.C.R.C. #2286 and road stationing from K.C.R.C. at the location of a K.C. Monument set by Nederveld & Associates in place of a 3/4" iron in a monument box which checked L.C.R.C. #413 and K.C. Surveyor's records.

L.C.R.C. #4905

- Nail and KC tag in W side PP S 14° W 132.56'
- Nail and KC tag in SE side PP N 48° E 64.56' (m. 64.55')
- Nail and KC tag in N side guy pole N 63° W 82.88' (m. 82.85')
- Nail and KC tag in SE side PP N 15° W 130.12' (m. 130.10)

L.C.R.C. #5033

- Nail & Remon. Tag NE side p. pole N 62° W 82.79'
- Nail & Remon. Tag SE side p. pole N 55° E 64.52'

The selected location is accepted by me and is generally accepted by professional surveyors as the best available evidence of the position of the original corner.


C. Description of monument for corner and accessories established to perpetuate locating the position of the corner:

E-3 Standard Kent County Monument

- Nail & K.C. remon. tag on S side (new) guy pole S 48° W 65.07'
- Nail & K.C. remon. tag on N side guy pole N 63° W 82.85'
- Nail & K.C. remon. tag on SW side P. pole N 15° W 130.10'
- Nail & K.C. remon. tag on NW side 16" Blk. Oak N 44° W 124.87'
- Nail & K.C. remon. tag on SE side P. pole N 48° E 64.55'
- Nail & K.C. remon. tag on W side P. pole S 14° W 132.56'

Signed by Randy Kolehouse  
 EARTH TECH

Date 7/23/96

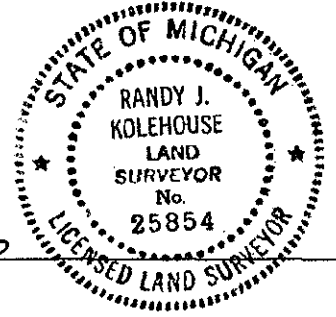

Surveyor's Michigan License No. 25854