

SURVEY & REMONUMENTATION

FEB 14 1997

COMMISSION

LAND CORNER RECORDATION CERTIFICATE
Filing Requirement of Act 74, Mich. P.A. 1970
KENT COUNTY REMONUMENTATION

For corners in


Kent (County)	Located in: Gaines Township	Corner Code #
1 Public Land Survey	T <u>5N</u> R <u>11W</u>	<u>E-4</u>
	T _____ R _____	_____
	T _____ R _____	_____
	T _____ R _____	_____
2 Property Controlling in Section	S _____ T _____ R _____	_____
	S _____ T _____ R _____	_____
3 Miscellaneous Property in Sec.	S _____ T _____ R _____	_____
	S _____ T _____ R _____	_____

STATE OF MICHIGAN
 COUNTY OF KENT
 RECEIVED FOR RECORD
 96 AUG -8 AM 8:42
 REG. OF DEEDS
Lucy St. Paul
9244
 Register of Deeds Stamp & File Number

4 Lot No. _____, Recorded Plat _____
 5 Private Claims _____

I, Randy Kolehouse, in a field survey on January 3 19 96, do hereby certify that under requirements of P.A. 74 Michigan P.A. of 1970, the corner points mentioned in lines 1 and 2 above were in conformance with regulations and rules therefore as required in the current manual of survey instructions of the United States Department of the Interior, Bureau of Land Management or by a decree of a Court of Law and/or that the corner points mentioned in lines 3, 4 and 5 above were in conformance with the rules of the Michigan Board of Land Surveyors or by a Decree of a Court of Law; established, re-established, monumented, re-monumented, recovered, found as expressed below:

NOTE: Not more than 4 corners, all in the same town and range, may be recorded on this certificate.

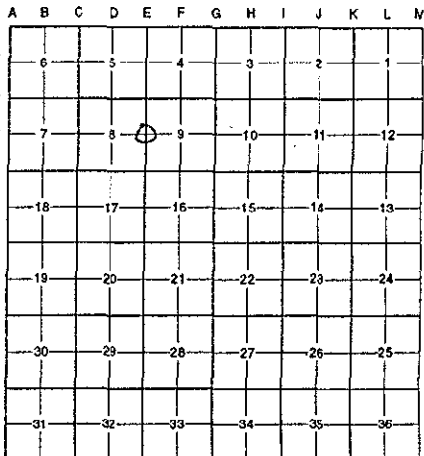

A Description of original monument and accessories and/or subsequent restoration:

E-4	Description	Surveyor	Monument
1831	G.L.O. Notes	Mullett	Set Post
1963	Witness Map	K.C. Surveyor	"+" in Concrete
1972	L.C.R.C. #644	Medema, Van Kooten & Assoc.	1/2" Iron in Mon. Box
1982	L.C.R.C. #2919	Exxel Engineering	Fnd. 1/2" Iron in Mon. Box / Set K.C. Monument
1989	L.C.R.C. #5034	J. Bueche	K.C. Monument

P.A. 345 1990 KENT COUNTY
 PEER APPROVED 3/6/96
 CHAIRMAN *Randy Kolehouse*

This corner was originally approved by the Kent County Remonumentation Peer Group and monumented by Exxel Engineering on 6/4/82 and was recorded per L.C.R.C. #2919.

B Description of corner evidence found and/or method applied in restoring or reestablishing corner:

E-4 Found a Standard Kent County Monument in a monument box 0.4' M/L East of the C/L of Kalamazoo Avenue (bit.) running N & S per L.C.R.C.'s #2919 and #5034 as set by Exxel Engineering in place of a 1/2" x 10" iron in a monument box they found which checked L.C.R.C. #644 and K.C. Surveyor's records.

L.C.R.C. #2919

L.C.R.C. #5034

Nail & KC tag in NE sde 24" Maple N 40° W 48.76'	Nail & Remon. Tag in NE side 28" Maple N 40° W 48.76'
PK & KC tag in E sde P. Pole N 13° W 109.35'	Nail & Remon. Tag in SE side p. pole S 20° W 123.45' (123.57')
	PK & Remon. Tag in E side p. pole N 13° W 109.35'

The selected location is accepted by me and is generally accepted by professional surveyors as the best available evidence of the position of the original corner.


C Description of monument for corner and accessories established to perpetuate locating the position of the corner:

E-4 Standard Kent County Monument in a Monument Box

- Most E'ly brick pillar to entrance of Crystal Spring Condos S 30° E 160.26'
- Nail & K.C. remon. tag on E side P. pole N 13° W 109.35'
- Nail & K.C. remon. tag on SE side P. pole S 20° W 123.57'
- Nail & K.C. remon. tag on NE side 28" Maple N 40° W 48.76'

Signed by *Randy J. Kolehouse*
 EARTH TECH

Date 7/23/96

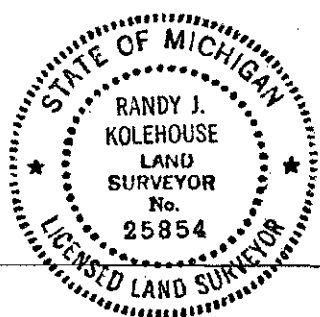

Surveyor's Michigan License No. 25854