

**SURVEY & REMONUMENTATION**

FEB 14 1997

COMMISSION

**LAND CORNER RECORDATION CERTIFICATE**  
**Filing Requirement of Act 74, Mich. P.A. 1970**  
**KENT COUNTY REMONUMENTATION**

For corners in

| Kent<br>(County)                     | Located in: | Gaines<br>Township | Corner Code # |
|--------------------------------------|-------------|--------------------|---------------|
| 1 Public Land Survey                 | T <u>5N</u> | R <u>11W</u>       | <u>E-5</u>    |
|                                      | T _____     | R _____            | _____         |
|                                      | T _____     | R _____            | _____         |
|                                      | T _____     | R _____            | _____         |
| 2 Property Controlling<br>in Section | S _____     | T _____            | R _____       |
|                                      | S _____     | T _____            | R _____       |
| 3 Miscellaneous<br>Property in Sec.  | S _____     | T _____            | R _____       |
|                                      | S _____     | T _____            | R _____       |

STATE OF MICHIGAN  
 COUNTY OF KENT  
 RECEIVED FOR RECORD

96 AUG -8 AM 8:42


REG. OF DEEDS

*David J. Huber*

**9245**

Register of Deeds Stamp & File Number

4 Lot No. \_\_\_\_\_, Recorded Plat \_\_\_\_\_  
 5 Private Claims \_\_\_\_\_

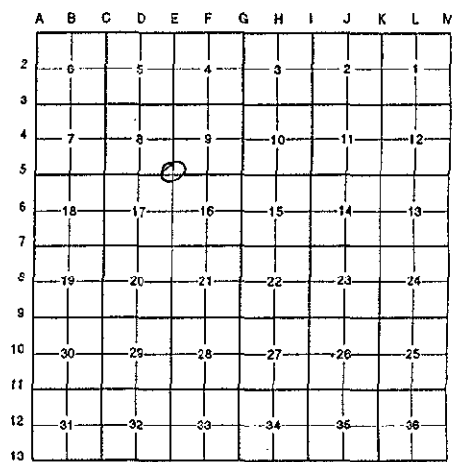

I, Randy Kolehouse, in a field survey on January 3 19 96, do hereby certify that under requirements of P.A. 74 Michigan P.A. of 1970, the corner points mentioned in lines 1 and 2 above were in conformance with regulations and rules therefore as required in the current manual of survey instructions of the United States Department of the Interior, Bureau of Land Management or by a decree of a Court of Law and/or that the corner points mentioned in lines 3, 4 and 5 above were in conformance with the rules of the Michigan Board of Land Surveyors or by a Decree of a Court of Law; established, re-established, monumented, re-monumented, recovered, found as expressed below:

NOTE: Not more than 4 corners, all in the same town and range, may be recorded on this certificate.

A Description of original monument and accessories and/or subsequent restoration:

|     |      |                |                    |  |                             |
|-----|------|----------------|--------------------|--|-----------------------------|
| E-5 | 1831 | G.L.O. Notes   | Mullett            | Set Post   | P.A. 345 1990 KENT COUNTY   |
|     | 1937 | Witness Map    | K.C. Surveyor      | Iron   | PEER APPROVED 3/27/96       |
|     | 1963 | Witness Map    | K.C. Surveyor      | Iron   | CHAIRMAN <i>Randy Huber</i> |
|     | 1974 | L.C.R.C. #770  | Nederveld & Jonker | Iron in Monument Box                                     |                             |
|     | 1981 | L.C.R.C. #1809 | William Byl        | Fnd. 1/2" in 1-1/2" Iron in Mon. Box / Set K.C. Monument |                             |
|     | 1989 | L.C.R.C. #5035 | J. Bueche          | K.C. Monument  |                             |

This corner was originally approved by the Kent County Remonumentation Peer Group and monumented by William Byl on 2/23/81 and was recorded per L.C.R.C. #1809.

B Description of corner evidence found and/or method applied in restoring or reestablishing corner:

E-5 Found a Standard Kent County Monument at the C/L intersection of Kalamazoo Avenue (bit.) running N & S and 76th Street (bit.) running E & W per L.C.R.C.'s #1809 and #5035 as set by William Byl in place of a 1/2" iron in a 1-1/2" iron in a monument box he found which checked L.C.R.C. #770 and K.C. Surveyor's.

| L.C.R.C. #1809   | L.C.R.C. #5035  |
|--|---|
| Nail & Tag E side 30" Maple S 20° W 85.40'             | Nail & Remon Tag in E side 36" Maple S 20° W 85.40'   |
| NW cor. porch foundation (House #7610) S 45° E 105.45' | NW cor porch foundation (House #7610) S 45° E 105.45' |

The selected location is accepted by me and is generally accepted by professional surveyors as the best available evidence of the position of the original corner.


C Description of monument for corner and accessories established to perpetuate locating the position of the corner:

E-5 Standard Kent County Monument

Nail & K.C. remon. tag on E side 36" Maple S 20° W 85.40'  
 NW cor. porch fndn. (hse. #7610) S 45° E 105.45'  
 Nail & K.C. remon. tag on SW side guy pole S 30° E 48.74'  
 Nail & K.C. remon. tag on E'ly side P. pole N 15° W 71.63'  
 Nail & K.C. remon. tag on NE side power-light pole N 50° W 58.10'

Signed by *Randy Kolehouse*

Date 7/23/96

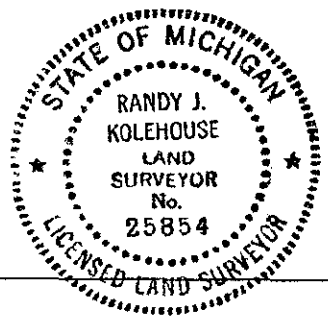

Surveyor's Michigan License No. 25854