

**SURVEY & REMONUMENTATION**

FEB 14 1997

COMMISSION

**LAND CORNER RECORDATION CERTIFICATE**  
**Filing Requirement of Act 74, Mich. P.A. 1970**  
**KENT COUNTY REMONUMENTATION**

For corners in

Kent (County)	Located in: Gaines Township	Corner Code #
1 Public Land Survey	T <u>5N</u> R <u>11W</u>	<u>E-7</u>
	T _____ R _____	_____
	T _____ R _____	_____
	T _____ R _____	_____
2 Property Controlling in Section	S _____ T _____ R _____	_____
	S _____ T _____ R _____	_____
3 Miscellaneous Property in Sec.	S _____ T _____ R _____	_____
	S _____ T _____ R _____	_____

STATE OF MICHIGAN  
 COUNTY OF KENT  
 RECEIVED FOR RECORD

96 AUG -8 AM 8:43

REG. OF DEEDS

*Lucy Stand*

9247

Register of Deeds Stamp & File Number

4 Lot No. \_\_\_\_\_, Recorded Plat \_\_\_\_\_  
 5 Private Claims \_\_\_\_\_

I, Randy Kolehouse, in a field survey on January 3 19 96, do hereby certify that under requirements of P.A. 74 Michigan P.A. of 1970, the corner points mentioned in lines 1 and 2 above were in conformance with regulations and rules therefore as required in the current manual of survey instructions of the United States Department of the Interior, Bureau of Land Management or by a decree of a Court of Law and/or that the corner points mentioned in lines 3, 4 and 5 above were in conformance with the rules of the Michigan Board of Land Surveyors or by a Decree of a Court of Law; established, re-established, monumented, re-monumented, recovered, found as expressed below:

	A	B	C	D	E	F	G	H	I	J	K	L	N
2	6	5	4	3	2	1							
3													
4	7	8	9	10	11	12							
5													
6	16	17	16	15	14	13							
7													
8	19	20	21	22	23	24							
9													
10	30	29	28	27	26	25							
11													
12	31	32	33	34	35	36							
13													

**NOTE: Not more than 4 corners, all in the same town and range, may be recorded on this certificate.**

A Description of original monument and accessories and/or subsequent restoration:

E-7	Description	Surveyor	Monument	P.A.
1831	G.L.O. Notes	Mullett	Set Post	P.A. 345 1990 KENT COUNTY
1944	Witness Map	K.C. Surveyor	Iron	PEER APPROVED 3/7/96
1963	Witness Map	K.C. Surveyor	Iron	CHAIRMAN <i>Harry Huber</i>
1974	L.C.R.C. #661	William Byl	Iron in Mon. Box	
1981	L.C.R.C. #1799	William Byl	Fnd. 1" Iron in Mon. Box / Set K.C. Monument	
1989	L.C.R.C. #5037	J. Bueche	K.C. Monument	

This corner was originally approved by the Kent County Remonumentation Peer Group and monumented by William Byl on 2/23/81 and was recorded per L.C.R.C. #1799.

B Description of corner evidence found and/or method applied in restoring or reestablishing corner:

E-7 Found a Standard Kent County Monument in a monument box at the C/L intersection of Kalamazoo Avenue (bit.) running N & S and 84th Street (bit.) running E & W per L.C.R.C.'s #661, #1799 and #5037 as set by William Byl in place of a 1" iron in a monument box that he found which checked L.C.R.C. #661 and K.C. Surveyor's records.

L.C.R.C. #1799

L.C.R.C. #5037

Nail & tag, N side Guy pole N 65° E 58.50'  
 Nail & tag, E side CP pole N 35° W 50.13'


Nail & Remon Tag N side Guy pole N 65° E 58.50'  
 Nail & Remon Tag E side CP pole N 35° W 50.13'  
 NW corner of stone foundation (1' above ground) of school house S 40° E 94.00'  
 Nail & Remon Tag in NW side 18" Apple S 30° W 102.40'

The selected location is accepted by me and is generally accepted by professional surveyors as the best available evidence of the position of the original corner.

C Description of monument for corner and accessories established to perpetuate locating the position of the corner:

E-7 Standard Kent County Monument in a Monument Box

Nail & Remon Tag N side Guy pole N 65° E 58.50'  
 Nail & Remon Tag E side CP pole N 35° W 50.13'  
 NW corner of stone foundation (1' above ground) of school house S 40° E 94.00'  
 Nail & Remon Tag in NW side 18" Apple S 30° W 102.40'

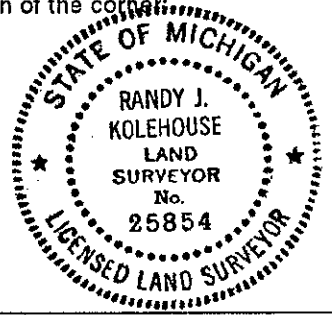

Signed by *Randy J. Kolehouse*  
 EARTH TECH

Date 7/23/96

Surveyor's Michigan License No. 25854