

FEB 14 1997

COMMISSION

LAND CORNER RECORDATION CERTIFICATE
Filing Requirement of Act 74, Mich. P.A. 1970
KENT COUNTY REMONUMENTATION

For corners in

Table with columns: Kent (County), Located in: Gains Township, Corner Code #. Rows include Public Land Survey, Property Controlling in Section, and Miscellaneous Property in Sec.

Register of Deeds Stamp & File Number. Includes handwritten signature, date 96 AUG -8 AM 8:43, and file number 9248.

4 Lot No. _____, Recorded Plat _____
5 Private Claims _____

Grid table with columns A-M and rows 2-13. Cell (8,21) contains a circled '0'.

I, Randy Kolehouse, in a field survey on January 2 19 96, do hereby certify that under requirements of P.A. 74 Michigan P.A. of 1970, the corner points mentioned in lines 1 and 2 above were in conformance with regulations and rules therefore as required in the current manual of survey instructions of the United States Department of the interior, Bureau of Land Management or by a decree of a Court of Law and/or that the corner points mentioned in lines 3, 4 and 5 above were in conformance with the rules of the Michigan Board of Land Surveyors or by a Decree of a Court of Law; established, re-established, monumented, re-monumented, recovered, found as expressed below:

NOTE: Not more than 4 corners, all in the same town and range, may be recorded on this certificate.

A Description of original monument and accessories and/or subsequent restoration:

Table with 4 columns: E-8, 1831, G.L.O. Notes, Mullet, Set Post; 1903, Survey Notes, Williams & Works, Stone & Crock; 1912-63, Survey Notes, Williams & Works, Stake / Mon. box; 1984, L.C.R.C. #3762 A&B, William Byl, Set K.C. Monument; 1989, L.C.R.C. #5038, J. Bueche, K.C. Monument

P.A. 345 1990 KENT COUNTY
PEER APPROVED 3/7/96
CHAIRMAN [Signature]

This corner was originally approved by the Kent County Remonumentation Peer Group and monumented by William Byl on 2/20/84 and was recorded per L.C.R.C. #3762 A&B.

B Description of corner evidence found and/or method applied in restoring or reestablishing corner:

E-8 Found a Standard Kent County Monument 4' M/L West of the C/L of Kalamazoo Avenue (bit.) running N & S on line of a fence running West as set by William Byl per L.C.R.C. #3762 A & B. Monument checks L.C.R.C.'s #3762 A and #5038.

L.C.R.C. #3762 A

L.C.R.C. #5038

Nail & tag, S sd. 8" Twin Elm N 75° E 119.90'
Nail & tag, E sd. Power pole N 25° W 102.91'

Nail & Remon. Tag S side 12" Twin Elm N 75° E 119.90' (m. 120.00')
Nail & Remon. Tag E side Power pole (4' high) N 25° W 102.91' (m. 102.99')

The selected location is accepted by me and is generally accepted by professional surveyors as the best available evidence of the position of the original corner.


C Description of monument for corner and accessories established to perpetuate locating the position of the corner:

E-8 Standard Kent County Monument

- Nail & K.C. remon. tag on N side 14" Poplar S 68° E 88.86'
Nail & K.C. remon. tag on W side 10" Elm S 40° W 49.75
Nail & K.C. remon. tag on E side RR N 25° W 102.99'
Nail & K.C. remon. tag on S side Tw. 14" Elm N 75° E 120.00'
Nail & Flasher #1409 in S side P. pole N 25° E 106.97'

Signed by [Signature] EARTH TECH

Date 7/23/96

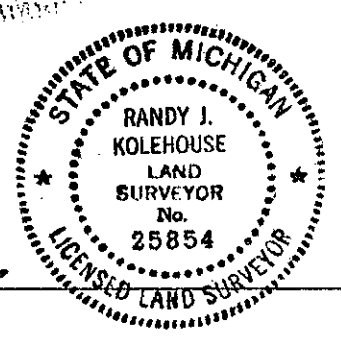

Surveyor's Michigan License No. 25854