

SURVEY & REMONUMENTATION

FEB 14 1997

COMMISSION

LAND CORNER RECORDATION CERTIFICATE
Filing Requirement of Act 74, Mich. P.A. 1970
KENT COUNTY REMONUMENTATION

For corners in

Kent (County)	Located in: Gains Township	Corner Code #
1. Public Land Survey	T <u>5N</u> R <u>11W</u>	<u>E-9</u>
	T _____ R _____	_____
	T _____ R _____	_____
	T _____ R _____	_____
2. Property Controlling in Section	S _____ T _____ R _____	_____
	S _____ T _____ R _____	_____
3. Miscellaneous Property in Sec.	S _____ T _____ R _____	_____
	S _____ T _____ R _____	_____
4. Lot No. _____, Recorded Plat _____		
5. Private Claims _____		

STATE OF MICHIGAN
COUNTY OF KENT
RECEIVED FOR RECORD

96 AUG -8 AM 8:43


REG. OF DEEDS

9249

Register of Deeds Stamp & File Number

I, Randy Kolehouse, in a field survey on January 2 19 96, do hereby certify that under requirements of P.A. 74 Michigan P.A. of 1970, the corner points mentioned in lines 1 and 2 above were in conformance with regulations and rules therefore as required in the current manual of survey instructions of the United States Department of the interior, Bureau of Land Management or by a decree of a Court of Law and/or that the corner points mentioned in lines 3, 4 and 5 above were in conformance with the rules of the Michigan Board of Land Surveyors or by a Decree of a Court of Law; established, re-established, monumented, re-monumented, recovered, found as expressed below:

NOTE: Not more than 4 corners, all in the same town and range, may be recorded on this certificate.

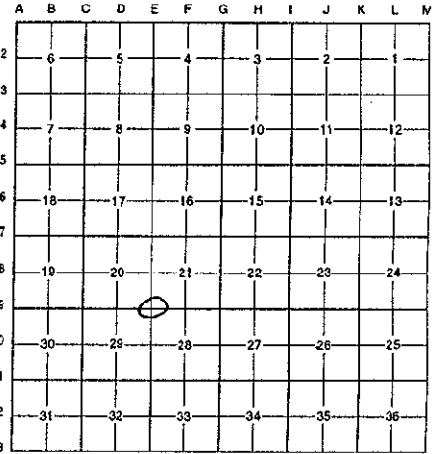

A. Description of original monument and accessories and/or subsequent restoration:

Date	Description	Location	Monument
1831	G.L.O. Notes	Mullett	Set Post
1903	Survey Records	Williams & Works	Sleigh Shoe
1942	Survey Records	Williams & Works	1" Iron and Sleigh shoe
1973	L.C.R.C. #418	Medema, Van Kooten & Assoc.	1/2" Iron in Mon. Box
1977	L.C.R.C. #1226	William Byl	Monument Box
1982	L.C.R.C. #3129	Exxel Engineering	Fnd. Iron in Mon. Box & Sleigh Shoe / Set K.C. Monument

P.A. 345 1990 KENT COUNTY
 PEER APPROVED 3/7/96
 CHAIRMAN Randy Kolehouse

This corner was originally approved by the Kent County Remonumentation Peer Group and monumented by Exxel Engineering on 9/20/82 and was recorded per L.C.R.C. #3129.

B. Description of corner evidence found and/or method applied in restoring or reestablishing corner:

E-9 Found a Standard Kent County Monument 3' M/L East of the C/L intersection of Kalamazoo Avenue (bit.) running N & S and 92nd Street (bit.) running E & W per L.C.R.C.'s #3129 and #5039 as set by Exxel Engineering in place of an iron in a monument box over a 3/4" iron over a sleigh shoe and stones (34" below road surface) they found which checked L.C.R.C.'s #418, #1226 and Williams & Works survey records.


L.C.R.C. #3129	L.C.R.C. #5039
NW corner brick church S 48° E 69.34'	NW corner brick church S 48° E 69.34' (m. 69.33')
Nail & KC remon tag in NW sde 30" Maple N 25° E 87.77'	Nail & Remon Tag in NW side 36" Maple N 25° E 87.77' (m. 87.78')
Nail & KC remon tag in S sde 24" Maple N 75° E 118.50'	Nail & Remon Tag in south side 30" Maple N 75° E 118.50' (m. 118.51')
C/L "X" blacktop road West 3' ±	

The selected location is accepted by me and is generally accepted by professional surveyors as the best available evidence of the position of the original corner.

C. Description of monument for corner and accessories established to perpetuate locating the position of the corner:

E-9 Standard Kent County Monument

- NW cor. brick church S 48° E 69.33'
- Nail & K.C. remon. tag on NW side 30" Maple N 25° E 87.78'
- Nail & K.C. remon. tag on S side 24" Maple N 75° E 118.51'
- Nail & K.C. remon. tag on MBT pole N 70° W 75.01'

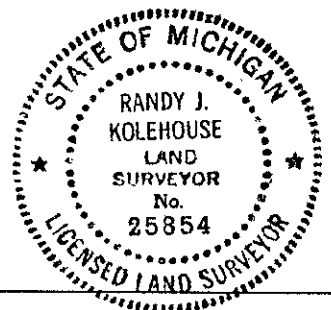

Signed by Randy J. Kolehouse
 EARTH TECH

Date 7/23/96

Surveyor's Michigan License No. 25854