

SURVEY & REMONUMENTATION

FEB 14 1997

COMMISSION


LAND CORNER RECORDATION CERTIFICATE
Filing Requirement of Act 74, Mich. P.A. 1970
KENT COUNTY REMONUMENTATION

For corners in

Kent (County)	Located in: Gaines Township	Corner Code #
1. Public Land Survey	T <u>5N</u> R <u>11W</u>	<u>E-10</u>
	T _____ R _____	_____
	T _____ R _____	_____
	T _____ R _____	_____
2. Property Controlling in Section	S _____ T _____ R _____	_____
	S _____ T _____ R _____	_____
3. Miscellaneous Property in Sec.	S _____ T _____ R _____	_____
	S _____ T _____ R _____	_____
4. Lot No. _____, Recorded Plat _____		
5. Private Claims _____		

STATE OF MICHIGAN
 COUNTY OF KENT
 RECEIVED FOR RECORD
 96 AUG -8 AM 8:43
 REG. OF DEEDS
 9250
 Register of Deeds Stamp & File Number

Randy Kolehouse, in a field survey on June 29 19 96, do hereby certify that under requirements of P.A. 74 Michigan P.A. of 1970, the corner points mentioned in lines 1 and 2 above were in conformance with regulations and rules therefore as required in the current manual of survey instructions of the United States Department of the interior, Bureau of Land Management or by a decree of a Court of Law and/or that the corner points mentioned in lines 3, 4 and 5 above were in conformance with the rules of the Michigan Board of Land Surveyors or by a Decree of a Court of Law; established, re-established, monumented, re-monumented, recovered, found as expressed below:

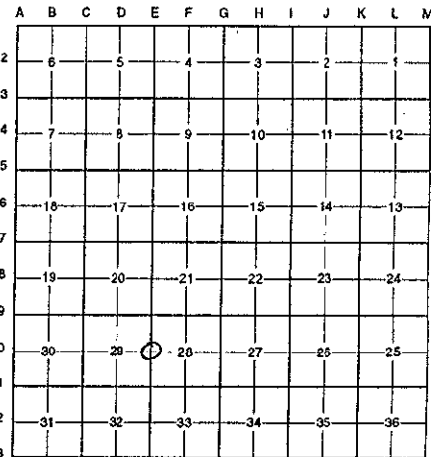

NOTE: Not more than 4 corners, all in the same town and range, may be recorded on this certificate.

A. Description of original monument and accessories and/or subsequent restoration:

E-10	1831	G.L.O. Notes	Mullett	Set Post
	1903	Notes	Williams & Works	Sleigh Shoe, Stones, Crockery
	N/A	Witness Map	K.C. Surveyor	Iron
	1973	L.C.R.C. #418	Medema, Van Kooten & Assoc.	1/2" Iron
	1984	L.C.R.C. #3738	William Byl	Frnd. Iron, Sleigh Shoe & Stones / Set K.C. Monument
	1989	L.C.R.C. #5040	J. Bueche	K.C. Monument

P.A. 345 1990 KENT COUNTY
 PEER APPROVED 3/17/96
 CHAIRMAN Randy Kolehouse

This corner was originally approved by the Kent County Remonumentation Peer Group and monumented by William Byl on 2/15/84 and was recorded per L.C.R.C. #3738.

B. Description of corner evidence found and/or method applied in restoring or reestablishing corner:

E-10 Found a Standard Kent County Monument 1' West of the C/L of Kalamazoo Avenue (bit.) running North and South on line of woods running East and West per L.C.R.C.'s #3738 and #5040 as set by W. Byl in place of an iron, sleigh shoe and stones he found which checked L.C.R.C. #418, the 1903 notes of Williams & Works and the K.C. Surveyor's records.


L.C.R.C. #3738	L.C.R.C. #5040
Nail & tag, N. sd. 18" Walnut S 80 W 76.48'	Nail & Remon. Tag N side 24" Walnut S 80° W 76.48' (m. 76.40')
Nail & tag, N. sd. 12" Hickory N 90 E 63.82'	Nail & Remon. Tag N side 16" Hickory (Elm) (5' high) N 90° E 63.82' (m. 63.70')
SE cor. brick veneer of house N 55 W 209.62'	SE corner brick veneer of house N 55° W 209.62' (m. 209.53')
	Nail & Remon. Tag in E. side P. pole S 35° W 95.75' (m. 95.80')
	C/L blacktop N-S East 0.8' ±

The selected location is accepted by me and is generally accepted by professional surveyors as the best available evidence of the position of the original corner.

C. Description of monument for corner and accessories established to perpetuate locating the position of the corner:

E-10 Standard Kent County Monument

Nail & K.C. remon. tag on N side 24" Walnut S 80° W 76.40'
 Nail & K.C. remon. tag on N side 16" Elm N 90° E 63.70'
 Nail & K.C. remon. tag on E side P. pole S 35° W 95.80'
 SE cor. brick veneer of house N 55° W 209.53'

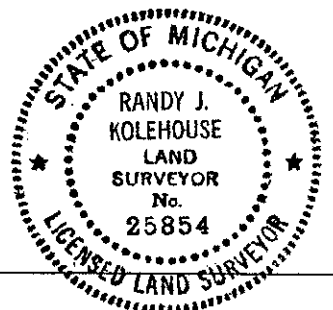

Signed by Randy J. Kolehouse Date 7/23/96

Surveyor's Michigan License No. 25854