

SURVEY & REMONUMENTATION

FEB 14 1997

COMMISSION

LAND CORNER RECORDATION CERTIFICATE
Filing Requirement of Act 74, Mich. P.A. 1970
KENT COUNTY REMONUMENTATION

For corners in

Kent (County)	Located in: Gains Township	Corner Code #
1. Public Land Survey	T <u>5N</u> R <u>11W</u>	<u>E-11</u>
	T _____ R _____	_____
	T _____ R _____	_____
	T _____ R _____	_____
2. Property Controlling in Section	S _____ T _____ R _____	_____
	S _____ T _____ R _____	_____
3. Miscellaneous Property in Sec.	S _____ T _____ R _____	_____
	S _____ T _____ R _____	_____
4. Lot No. _____, Recorded Plat _____		
5. Private Claims _____		

STATE OF MICHIGAN
 COUNTY OF KENT
 RECEIVED FOR RECORD
 96 AUG -8 AM 8:43
 REG. OF DEEDS
 9251

Register of Deeds Stamp & File Number

	A	B	C	D	E	F	G	H	I	J	K	L	M
2	6		5		4		3		2		1		
3													
4	7		8		9		10		11		12		
5													
6	16		17		18		15		14		13		
7													
8	19		20		21		22		23		24		
9													
10	30		29		28		27		26		25		
11													
12	31		32		33		34		35		36		
13													

I, Randy Kolehouse, in a field survey on January 25 19 96, do hereby certify that under requirements of P.A. 74 Michigan P.A. of 1970, the corner points mentioned in lines 1 and 2 above were in conformance with regulations and rules therefore as required in the current manual of survey instructions of the United States Department of the interior, Bureau of Land Management or by a decree of a Court of Law and/or that the corner points mentioned in lines 3, 4 and 5 above were in conformance with the rules of the Michigan Board of Land Surveyors or by a Decree of a Court of Law; established, re-established, monumented, re-monumented, recovered, found as expressed below:

NOTE: Not more than 4 corners, all in the same town and range, may be recorded on this certificate.

A. Description of original monument and accessories and/or subsequent restoration:

E-11	1831	G.L.O. Notes	Mullett	Set Post
	1961	Wit. Map	K.C. Surveyor	Mon. Box
	1973	L.C.R.C. #509	Exxel Engineering	2.5" Iron in Mon. Box
	1982	L.C.R.C. #2930	Exxel Engineering	Fnd. 2.5" Iron in Mon. Box / Set K.C. Monument in Mon. Box
	1989	L.C.R.C. #5041	J. Bueche	K.C. Mon. in Mon. Box

P.A. 345 1990 KENT COUNTY

PEER APPROVED 3/7/96

CHAIRMAN Randy Kolehouse

This corner was originally approved by the Kent County Remonumentation Peer Group and monumented by Exxel Engineering on 5/3/82 and was recorded per L.C.R.C. #2930.

B. Description of corner evidence found and/or method applied in restoring or reestablishing corner:

E-11 Found a Standard Kent County Monument in a monument box 5.3' East of C/L of Kalamazoo Avenue (bit.) running N-S and the C/L of 100th Street (bit.) running E-W as set by Exxel Engineering in place of a 2.5" iron they found in a monument box which checked L.C.R.C. #509 and K.C. Surveyor's records.

L.C.R.C. #2930

L.C.R.C. #5041

KC tag and Nail in West side 24" Maple S 12° E 118.45'
 PK in KC tag in top of concrete headwall S 55° E 60.67'
 PK in KC tag in top of concrete headwall N 15° E 103.31'
 Nail and KC tag in NE side P. Pole N 44° W 43.50'
 PK in KC tag in top of concrete headwall S 27° W 57.38'
 C/L "X" of roads 5.3' ± West


Nail & Remon Tag in West side 28" Maple S 12° E 118.45'
 PK in Remon Tag in top of concrete headwall S 55° E 60.67'
 PK in Remon Tag in top of concrete headwall N 15° E 103.31'
 New Nail & Remon tag in NE side p. pole N 44° W 42.45' (m. 42.40')
 PK in Remon tag in top of concrete headwall S 27° W 57.38' (m. 57.40')

The selected location is accepted by me and is generally accepted by professional surveyors as the best available evidence of the position of the original corner.

C. Description of monument for corner and accessories established to perpetuate locating the position of the corner:

E-11 Standard Kent County Monument in a Monument Box

Nail & K.C. remon. tag on W side 28" Maple N 05° E 246.13'
 Nail & K.C. remon. tag on NE side P. & L. pole N 44° W 42.40'
 PK & tag top conc. headwall S 27° W 57.40'
 Nail & K.C. remon. tag on W wide 28" Maple S 12° E 118.45'
 PK & tag top conc. headwall S 55° E 60.67'
 PK & tag top conc. headwall N 15° E 103.31'

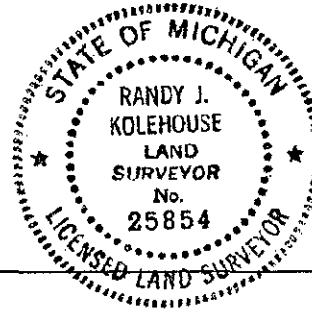

Signed by Randy J. Kolehouse
 EARTH TECH

Date 7/23/96

Surveyor's Michigan License No. 25854