

JAN 23 1996

COMMISSION

LAND CORNER RECORDATION CERTIFICATE  
Filing Requirement of Act 74, Mich. P.A. 1970  
KENT COUNTY REMONUMENTATION

For corners in

Kent (County)	Located in:	Corner Code #
1. Public Land Survey	T 5N R 11W	F-2
	T _____ R _____	_____
	T _____ R _____	_____
	T _____ R _____	_____
2. Property Controlling in Section	S _____ T _____ R _____	_____
	S _____ T _____ R _____	_____
3. Miscellaneous Property in Sec.	S _____ T _____ R _____	_____
	S _____ T _____ R _____	_____


STATE OF MICHIGAN  
COUNTY OF KENT  
RECEIVED FOR RECORD

95 DEC 28 PM 2:21

REG. OF DEEDS  
*Lucy Bond*  
8910

Register of Deeds Stamp & File Number

- 4. Lot No. \_\_\_\_\_, Recorded Plat \_\_\_\_\_
- 5. Private Claims \_\_\_\_\_

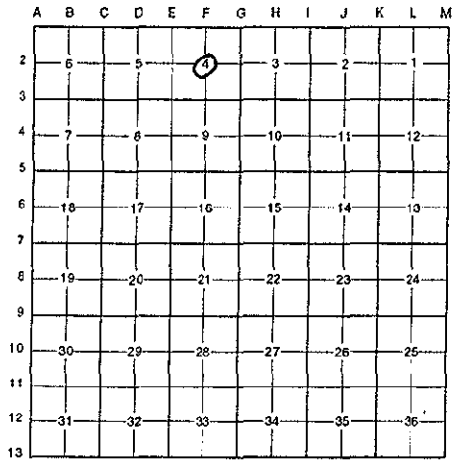

I, Randy Kolehouse, in a field survey on May 19 19 95, do hereby certify that under requirements of P.A. 74 Michigan P.A. of 1970, the corner points mentioned in lines 1 and 2 above were in conformance with regulations and rules therefore as required in the current manual of survey instructions of the United States Department of the Interior, Bureau of Land Management or by a decree of a Court of Law and/or that the corner points mentioned in lines 3, 4 and 5 above were in conformance with the rules of the Michigan Board of Land Surveyors or by a Decree of a Court of Law; established, re-established, monumented, re-monumented, recovered, found as expressed below:

NOTE: Not more than 4 corners, all in the same town and range, may be recorded on this certificate.

A. Description of original monument and accessories and/or subsequent restoration:

F-2 This corner was not originally set by the G.L.O.

1989	Survey Notes	Exxel Engineering	Set Iron at Int. 1/4 Lines
1992	L.C.R.C. #6650	Chris Marschall	Set K.C. Monument at Int. 1/4 Lines

P.A. 345 1990 KENT COUNTY  
PEER APPROVED 10/26/95  
CHAIRMAN *Harry Kube*

B. Description of corner evidence found and/or method applied in restoring or reestablishing corner:


F-2 Found Kent County Monument which checks witnesses from L.C.R.C. #6650 as set by Chris Marschall at intersection of 1/4 lines. This Kent County Monument also checks witnesses from Exxel Engineering who set an iron at intersection 1/4 lines in 1989. Accepted Kent County Monument as the Center of Section.

Exxel Engineering	L.C.R.C. #6650
Nail in S'y side P. pole W-NW 63.01' (E'y Pole)	K.C. Nail & Tag S sde. 8" Twin Poplar N 87° E 19.37'
Nail in S'y side 8" Poplar E 19.43'	K.C. Nail & Tag W sde. 32" Beech N 2° W 32.74'
Nail in W'y side 32" Beech N 32.74'	K.C. Nail & Tag N sde. of E. P.P. (5' above ground) N 85° W 63.09'
Nail in W'y side 12" Twin Elm S-SE 45.21'	K.C. Nail & Tag W sde. of 14" Twin Elm S 10° E 45.17'
	K.C. Nail & Tag SW sde. of 8" Basswood N 45° W 24.26'

C. Description of monument for corner and accessories established to perpetuate locating the position of the corner:

F-2 Standard Kent County Monument

Nail & K.C. remon. tag in S side 8" Twin Poplar N 87° E 19.37'  
Nail & K.C. remon. tag in W side 32" Beech N 2° W 32.74'  
Nail & K.C. remon. tag in N side of E. P.P. (5' above ground) N 85° W 63.09'  
Nail & K.C. remon. tag in W side of 14" Twin Elm S 10° E 45.17'  
Nail & K.C. remon. tag in SW side of 8" Basswood N 45° W 24.26'

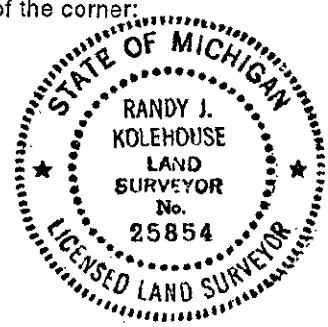

Signed by Randy J. Kolehouse Date 12/22/95  
EARTH TECH

Surveyor's Michigan License No. 25854