

SURVEY & REMONUMENTATION

FEB 14 1997

COMMISSION


LAND CORNER RECORDATION CERTIFICATE
Filing Requirement of Act 74, Mich. P.A. 1970
KENT COUNTY REMONUMENTATION

For corners in

Kent (County)	Located in: Gaines Township	Corner Code #
1. Public Land Survey	T <u>5N</u> R <u>11W</u>	<u>F-3</u>
	T _____ R _____	_____
	T _____ R _____	_____
	T _____ R _____	_____
2. Property Controlling in Section	S _____ T _____ R _____	_____
	S _____ T _____ R _____	_____
3. Miscellaneous Property in Sec.	S _____ T _____ R _____	_____
	S _____ T _____ R _____	_____
4. Lot No. _____, Recorded Plat _____		
5. Private Claims _____		

STATE OF MICHIGAN
 COUNTY OF KENT
 RECEIVED FOR RECORD
 96 AUG -8 AM 8:43
 REG. OF DEEDS
Lucy St. Grand

9255
 Register of Deeds Stamp & File Number

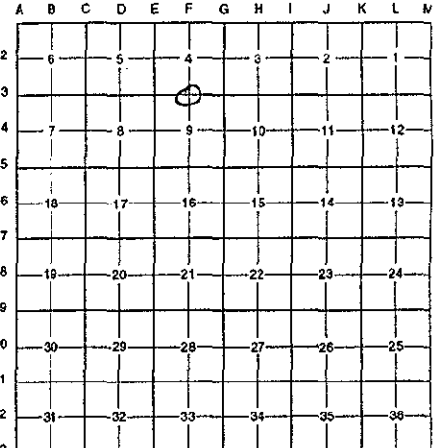

I, Randy Kolehouse, in a field survey on June 21, 19 96, do hereby certify that under requirements of P.A. 74 Michigan P.A. of 1970, the corner points mentioned in lines 1 and 2 above were in conformance with regulations and rules therefore as required in the current manual of survey instructions of the United States Department of the interior, Bureau of Land Management or by a decree of a Court of Law and/or that the corner points mentioned in lines 3, 4 and 5 above were in conformance with the rules of the Michigan Board of Land Surveyors or by a Decree of a Court of Law; established, re-established, monumented, re-monumented, recovered, found as expressed below:

NOTE: Not more than 4 corners, all in the same town and range, may be recorded on this certificate.

A. Description of original monument and accessories and/or subsequent restoration:

F-3	1831	G.L.O. Notes	Mullett	Set Post
	N/A	Witness Map	K.C. Surveyor	3/4" Iron Pipe
	1972	L.C.R.C. #171	F.E. Spicer	Iron in Mon. Box
	1982	L.C.R.C. #2921	Exxel Engineering	Fnd. Iron / Set K.C. Monument in Mon. Box
	1989	L.C.R.C. #5044	J. Bueche	K.C. Monument in Mon. Box

P.A. 345 1990 KENT COUNTY
 PEER APPROVED 2/7/96
 CHAIRMAN *Harold Huber*

This corner was originally approved by the Kent County Remonumentation Peer Group and monumented by Exxel Engineering on 6/4/82 and was recorded per L.C.R.C. #2921

B. Description of corner evidence found and/or method applied in restoring or reestablishing corner:

F-3 Found a Standard Kent County Monument in the C/L of 68th Street (bit.) running East and West per L.C.R.C.'s #2921 and #5044 as set by Exxel Engineering in place of an iron pipe they found which checked L.C.R.C. #171 and the K.C. Surveyor's records.

L.C.R.C. #2921

L.C.R.C. #5044


PK & KC tag in NE sde P. Pole S 72° E 138.08'	PK & Remon. Tag in NE side P. Pole S 72° E 138.08' (m. 133.19')
PK & KC tag in W sde P. Pole N 47° E 105.56'	PK & Remon. Tag in W side P. Pole N 47° E 105.56' (m. 105.60')
Nail & KC tag in E sde 8" Hickory N 05° W 42.38'	Nail & Remon. Tag in E side 10" Hickory (Elm) N 05° W 42.38'
	on C/L blacktop E-W
	C/L Power Line N-S East 80' ±

The selected location is accepted by me and is generally accepted by professional surveyors as the best available evidence of the position of the original corner.

C. Description of monument for corner and accessories established to perpetuate locating the position of the corner:

F-3 Standard Kent County Monument in a Monument Box

- PK & K.C. remon. tag on NE side P. pole S 72° E 138.19'
- PK & K.C. remon. tag on W side P. pole N 47° E 105.60'
- Nail & K.C. remon. tag on E side 10" Elm N 05° W 42.38'
- PK & K.C. remon. tag on NE side P. pole S 30° E 41.33'
- Capped rebar #16035 Chettelburg N 00° W 39.99'

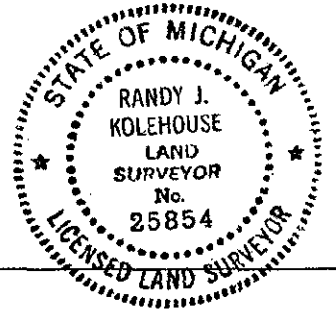

Signed by *Randy J. Kolehouse* Date 7/23/96

Surveyor's Michigan License No. 25854