

SURVEY & REMONUMENTATION

FEB 14 1997

COMMISSION

LAND CORNER RECORDATION CERTIFICATE
Filing Requirement of Act 74, Mich. P.A. 1970
KENT COUNTY REMONUMENTATION

For corners in


Kent (County)	Located in: Gains Township	Corner Code #
1. Public Land Survey	T <u>5N</u> R <u>11W</u>	<u>F-5</u>
	T _____ R _____	_____
	T _____ R _____	_____
	T _____ R _____	_____
2. Property Controlling in Section	S _____ T _____ R _____	_____
	S _____ T _____ R _____	_____
3. Miscellaneous Property in Sec.	S _____ T _____ R _____	_____
	S _____ T _____ R _____	_____

STATE OF MICHIGAN
 COUNTY OF KENT
 RECEIVED FOR RECORD
 96 AUG -8 AM 8:43
 REG. OF DEEDS
Tim Stand

9256
 Register of Deeds Stamp & File Number

4. Lot No. _____, Recorded Plat _____
 5. Private Claims _____

I, Randy Kolehouse, in a field survey on December 29 19 95, do hereby certify that under requirements of P.A. 74 Michigan P.A. of 1970, the corner points mentioned in lines 1 and 2 above were in conformance with regulations and rules therefore as required in the current manual of survey instructions of the United States Department of the interior, Bureau of Land Management or by a decree of a Court of Law and/or that the corner points mentioned in lines 3, 4 and 5 above were in conformance with the rules of the Michigan Board of Land Surveyors or by a Decree of a Court of Law; established, re-established, monumented, re-monumented, recovered, found as expressed below:

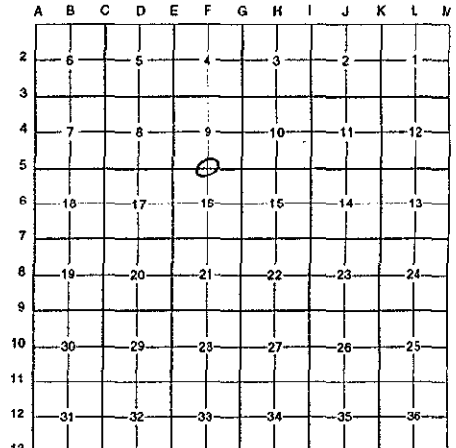

NOTE: Not more than 4 corners, all in the same town and range, may be recorded on this certificate.

A. Description of original monument and accessories and/or subsequent restoration:

F-5	1831	G.L.O. Notes	Mullett	Set Post
	N/A	Witness Map	K.C. Surveyor	Mon. Box
	1972	L.C.R.C. #165	Medema, Van Kooten & Assoc.	5/8" Rod in Mon. Box
	1981	L.C.R.C. #1742	Williams & Works	Fnd. 5/8" Rod in Mon. Box / Set K.C. Monument
	1989	L.C.R.C. #5045	J. Bueche	K.C. Monument

P.A. 345 1990 KENT COUNTY
 PEER APPROVED 3/7/96
 CHAIRMAN Randy Kolehouse

This corner was originally approved by the Kent County Remonumentation Peer Group and monumented by Williams & Works on 12/18/81 and was recorded per L.C.R.C. #1742.

B. Description of corner evidence found and/or method applied in restoring or reestablishing corner:

F-5 Found a Standard Kent County Monument 0.5' South of C/L of 76th Street (bit.) running E-W on line of tree rows running N & S per L.C.R.C.'s #1742 and #5045 as set by Williams & Works in place of 5/8" rod they found in monument box which checked L.C.R.C. #165 and K.C. Surveyor's records.

L.C.R.C. #1742

L.C.R.C. #5045

Nail & K.C. Remon. Tag in West Side 36" Maple S 09° W 56.80'
 Nail & K.C. Remon. Tag in South Side 10" Tw. Maple S 65° W 64.65'
 Nail & K.C. Remon. Tag in North Side 36" Beech N 75° E 91.24'
 Nail & K.C. Remon. Tag in East Side P. Pole North 63.90'
 Northwest Corner Hse. Fnd. #2016 S 45° E 111.25'


Nail & Remon Tag in W side 40" Maple S 09° W 56.80'
 Nail & Remon Tag in N side 40" Beech N 75° E 91.24'
 Nail & remon Tag in E side p. pole North 63.90'
 Northwest corner hse fnd # 2016 S 45° E 111.25'

The selected location is accepted by me and is generally accepted by professional surveyors as the best available evidence of the position of the original corner.

C. Description of monument for corner and accessories established to perpetuate locating the position of the corner:

F-5 Standard Kent County Monument

Nail & K.C. remon. tag on W side 40" Maple S 09° W 56.80'
 Nail & K.C. remon. tag on E side 14" Twin Maple S 65° W 64.65'
 Nail & K.C. remon. tag on N side 40" Beech N 75° E 91.24'
 Nail & K.C. remon. tag on E side P. pole North 63.90'
 NW cor. hse. fndn. #2016 S 45° E 111.25'

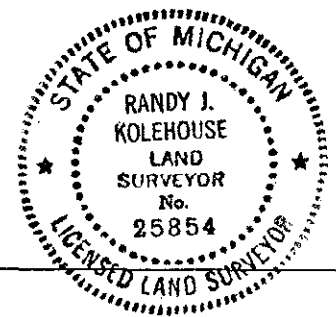

Signed by Randy J. Kolehouse
 EARTH TECH

Date 7/23/96

Surveyor's Michigan License No. 25854