

**SURVEY &
REMONUMENTATION**

FEB 14 1996 LAND CORNER RECORDATION CERTIFICATE
Filing Requirement of Act 74, Mich. P.A. 1970
COMMISSION KENT COUNTY REMONUMENTATION

For corners in

Kent (County)	Located in: Gains Township	Corner Code #
1. Public Land Survey	T <u>5N</u> R <u>11W</u>	<u>E-7</u>
	T _____ R _____	_____
	T _____ R _____	_____
	T _____ R _____	_____
2. Property Controlling In Section	S _____ T _____ R _____	_____
	S _____ T _____ R _____	_____
3. Miscellaneous Property in Sec.	S _____ T _____ R _____	_____
	S _____ T _____ R _____	_____

STATE OF MICHIGAN
 COUNTY OF KENT
 RECEIVED FOR RECORD


96 AUG - 8 AM 8:43

REG. OF DEEDS
[Signature]
 9257

Register of Deeds Stamp & File Number

4. Lot No. _____, Recorded Plat _____
 5. Private Claims _____

I, Randy Kolehouse, in a field survey on January 3 19 96, do hereby certify that under requirements of P.A. 74 Michigan P.A. of 1970, the corner points mentioned in lines 1 and 2 above were in conformance with regulations and rules therefore as required in the current manual of survey instructions of the United States Department of the Interior, Bureau of Land Management or by a decree of a Court of Law and/or that the corner points mentioned in lines 3, 4 and 5 above were in conformance with the rules of the Michigan Board of Land Surveyors or by a Decree of a Court of Law; established, re-established, monumented, re-monumented, recovered, found as expressed below:

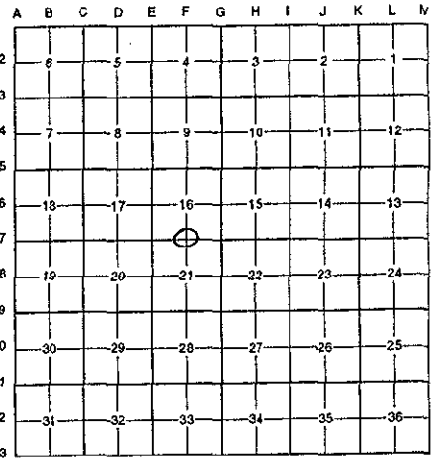

NOTE: Not more than 4 corners, all in the same town and range, may be recorded on this certificate.

A. Description of original monument and accessories and/or subsequent restoration:

F-7	1831	G.L.O. Notes	Mullett	Set Post
	1914	Survey Records	Williams & Works	2" Iron
	1944	Witness Map	K.C. Surveyor	2" Iron
	1960	Survey Records	Williams & Works	2" Iron
	1974	L.C.R.C. #719	Nederveld & Jonker	Iron in Mon. Box
	1981	L.C.R.C. #1800	William Byl	Fnd. 1" Iron in Mon. Box / Set K.C. Monument
	1989	L.C.R.C. #5046	J. Bueche	K.C. Monument

P.A. 345 1990 KENT COUNTY
 PEER APPROVED 3/2/96
 CHAIRMAN *[Signature]*

This corner was originally approved by the Kent County Remonumentation Peer Group and monumented by William Byl on 2/23/81 and was recorded per L.C.R.C. #1800.

B. Description of corner evidence found and/or method applied in restoring or reestablishing corner:

F-7 Found a Standard Kent County Monument in a monument box at the C/L of 84th Street (bit.) running E & W per L.C.R.C.'s #1800 and #5046 as set by William Byl in place of a 1" iron in a monument box he found that checked L.C.R.C. #719, Williams & Works' survey records and K.C. Surveyor's records.

L.C.R.C. #1800

Chiseled "X" on South end 36" concrete culvert S 20° W 29.37'
 Chiseled "X" on North end 36" concrete culvert N 15° W 30.54'
 Nail & tag, S side CP pole N 65° E 198.11'

L.C.R.C. #5046


Chiseled "X" on South end 36" concrete culvert S 20° W 29.37'
 Chiseled "X" on North end 36" concrete culvert N 15° W 30.54'
 Nail & Remon Tag S side CP pole N 65° E 198.11'
 Nail & Remon Tag W side 10" Poplar N 05° E 51.16'

The selected location is accepted by me and is generally accepted by professional surveyors as the best available evidence of the position of the original corner.

C. Description of monument for corner and accessories established to perpetuate locating the position of the corner:

F-7 Standard Kent County Monument in a Monument Box

- Nail & K.C. remon. tag on NW side 8" Ash S 50° W 65.11'
- Nail & K.C. remon. tag on W side 14" Sycamore N 05° E 51.16'
- Nail & K.C. remon. tag on E side 8" Ash N 05° W 43.65'
- Nail & K.C. remon. tag on S side CP pole N 65° E 198.23'
- "X" cut on S end 36" culvert S 20° W 29.37'
- "X" cut on N end 36" culvert N 15° W 30.54'

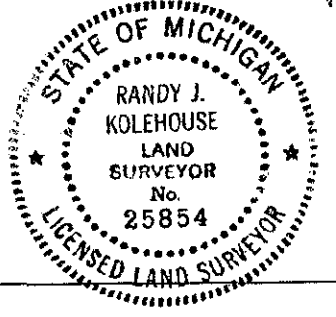

Signed by Randy J. Kolehouse Date 7/23/96
 EARTH TECH
 Surveyor's Michigan License No. 25854