

SURVEY & REMONUMENTATION

FEB 14 1997

COMMISSION AND CORNER RECORDATION CERTIFICATE

Filing Requirement of Act 74, Mich. P.A. 1970

KENT COUNTY REMONUMENTATION

For corners in

Kent (County)	Located in: Gains Township	Corner Code #
1. Public Land Survey	T <u>5N</u> R <u>11W</u>	<u>E-9</u>
	T _____ R _____	_____
	T _____ R _____	_____
	T _____ R _____	_____
2. Property Controlling in Section	S _____ T _____ R _____	_____
	S _____ T _____ R _____	_____
3. Miscellaneous Property in Sec.	S _____ T _____ R _____	_____
	S _____ T _____ R _____	_____

STATE OF MICHIGAN
COUNTY OF KENT
RECEIVED FOR RECORD

96 AUG -8 AM 8:43

REG. OF DEEDS

Randy Kolehose


9258

Register of Deeds Stamp & File Number

4. Lot No. _____, Recorded Plat _____
5. Private Claims _____

I, Randy Kolehose, in a field survey on January 2 19 96, do hereby certify that under requirements of P.A. 74 Michigan P.A. of 1970, the corner points mentioned in lines 1 and 2 above were in conformance with regulations and rules therefore as required in the current manual of survey instructions of the United States Department of the Interior, Bureau of Land Management or by a decree of a Court of Law and/or that the corner points mentioned in lines 3, 4 and 5 above were in conformance with the rules of the Michigan Board of Land Surveyors or by a Decree of a Court of Law; established, re-established, monumented, re-monumented, recovered, found as expressed below:

NOTE: Not more than 4 corners, all in the same town and range, may be recorded on this certificate.

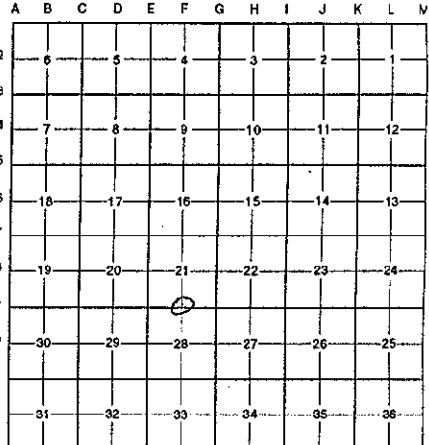

A. Description of original monument and accessories and/or subsequent restoration:

F-9	1831	G.L.O. Notes	Mullett	Set Post
	1944	Witness Map	K.C. Surveyor	2" Pipe
	1977	L.C.R.C. #1226	William Byl	"T" Iron
	1981	L.C.R.C. #1805	William Byl	Fnd. "T" Iron / Set K.C. Monument
	1989	L.C.R.C. #5047	J. Bueche	K.C. Monument

P.A. 345 1990 KENT COUNTY
PEER APPROVED 3/2/96
CHAIRMAN *Henry Huber*

This corner was originally approved by the Kent County Remonumentation Peer Group and monumented by William Byl on 2/24/81 and was recorded per L.C.R.C. #1805.

B. Description of corner evidence found and/or method applied in restoring or reestablishing corner:

F-9 Found a Standard Kent County Monument 4' M/L North of the C/L of 92nd Street (bit.) running E & W on line of fence running South and a tree row running North per L.C.R.C.'s #1805 and #5047 as set by William Byl in place of a "T" iron over a 1/2" re-rod inside a 1-1/2" iron (30" deep) that he found which checked L.C.R.C. #1226 and K.C. Surveyor's records.


L.C.R.C. #1805	L.C.R.C. #5047
Nail & tag, E side 14" Maple N 40° E 27.16'	New Nail & Remon Tag E side 18" Maple N 40° E 27.16'
Nail & tag, E side 6" Maple N 05° W 35.27'	Nail & Remon Tag E side 10" Maple N 05° W 35.27'
Nail & tag, E side 22" Maple S 45° E 46.24'	Nail & Remon Tag E side 26" Maple S 45° E 46.24'
Nail & tag, W side 30" Maple S 10° E 37.63'	Nail & Remon Tag W side 36" Maple S 10° E 37.63'
	Nail & Remon Tag N side 12" Poplar S 80° W 97.27' (m. 97.34')

The selected location is accepted by me and is generally accepted by professional surveyors as the best available evidence of the position of the original corner.

C. Description of monument for corner and accessories established to perpetuate locating the position of the corner:

F-9 Standard Kent County Monument

Nail & K.C. remon. tag on E side Twin 12" Maple N 00° E 31.59'
Nail & K.C. remon. tag on E side 18" Maple N 40° E 27.16'
Nail & K.C. remon. tag on E side 26" Maple S 45° E 46.24'
Nail & K.C. remon. tag on N side 12" Poplar S 80° W 97.34'
Nail & K.C. remon. tag on E side 10" Maple N 05° W 35.27'

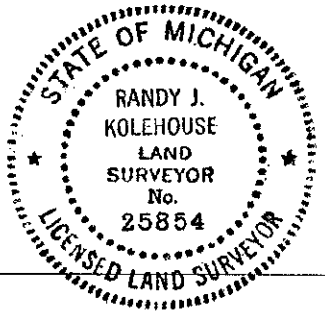

Signed by *Randy J. Kolehose* Date 7/23/96
EARTH TECH

Surveyor's Michigan License No. 25854