

SURVEY & REMONUMENTATION

FEB 14 1997

COMMISSION

LAND CORNER RECORDATION CERTIFICATE
Filing Requirement of Act 74, Mich. P.A. 1970
KENT COUNTY REMONUMENTATION

For corners in

Kent (County)	Located in: Gaines Township	Corner Code #
1. Public Land Survey	T <u>5N</u> R <u>11W</u>	<u>F-13</u>
	T _____ R _____	_____
	T _____ R _____	_____
	T _____ R _____	_____
2. Property Controlling in Section	S _____ T _____ R _____	_____
	S _____ T _____ R _____	_____
3. Miscellaneous Property in Sec.	S _____ T _____ R _____	_____
	S _____ T _____ R _____	_____

STATE OF MICHIGAN
 COUNTY OF KENT
 RECEIVED FOR RECORD

96 AUG -8 AM 8:44

REG. OF DEEDS
Lucy Spack

9262

Register of Deeds Stamp & File Number

4. Lot No. _____, Recorded Plat _____
 5. Private Claims _____

	A	B	C	D	E	F	G	H	I	J	K	L	N
2	6	5	4	3	2	1							
3													
4	7	8	9	10	11	12							
5													
6	18	17	16	15	14	13							
7													
8	19	20	21	22	23	24							
9													
10	30	29	28	27	26	25							
11													
12	31	32	33	34	35	36							
13													

I, Randy Kolehouse, in a field survey on January 18 19 96, do hereby certify that under requirements of P.A. 74 Michigan P.A. of 1970, the corner points mentioned in lines 1 and 2 above were in conformance with regulations and rules therefore as required in the current manual of survey instructions of the United States Department of the interior, Bureau of Land Management or by a decree of a Court of Law and/or that the corner points mentioned in lines 3, 4 and 5 above were in conformance with the rules of the Michigan Board of Land Surveyors or by a Decree of a Court of Law; established, re-established, monumented, re-monumented, recovered, found as expressed below:

NOTE: Not more than 4 corners, all in the same town and range, may be recorded on this certificate.

A. Description of original monument and accessories and/or subsequent restoration:

F-13	1817	G.L.O. Notes	L. Lyon	Set Post
	1918	Survey Records	Williams & Works	Stone
	1941	Road Plans	K.C.R.C.	Bt. Spike
	1983	L.C.R.C. #3392	William Byl	Set K.C. Monument
	1989	L.C.R.C. #5049	J. Bueche	K.C. Monument

Note: This corner is not common with F-1, T4N, R11W.
 This corner was originally approved by the Kent County Remonumentation Peer Group and monumented by William Byl on 4/21/83 and was recorded per L.C.R.C. #3392.

P.A. 345 1990 KENT COUNTY
 PEER APPROVED 3/17/96
 CHAIRMAN Harry Huber

B. Description of corner evidence found and/or method applied in restoring or reestablishing corner:

F-13 Found a Standard Kent County Monument at the C/L intersection of 108th Street (bit.) running East (gravel) running West and Kalamazoo Avenue (bit.) running N & S as set by William Byl using Williams & Works survey records and K.C.R.C. road plans. Checks 83.17' East of F-1, T4N, R11W.


L.C.R.C. #3392	L.C.R.C. #5049
NW cor, Conc. Block Bldg. S 30° E 98.24'	NW corner, concrete block building S 30° E 98.24' (m. 98.16')
SW cor, House foundation N 30° E 168.06'	SW corner, house foundation N 30° E 168.06' (m. 167.95')
Nail & tag, N sd. Power pole N 75° W 83.15'	Nail & Remon Tag, N side Power pole N 75° W 83.15' (m. 83.08')
Nail & tag, S sd. 30" Walnut N 65° E 64.31'	Nail & Remon. Tag, S side 34" Walnut N 65° E 64.31'
	Nail & Remon. Tag, S side 26" Walnut S 75° W 111.35'
	on C/L blacktop N-S, C/L blacktop East, C/L gravel West

The selected location is accepted by me and is generally accepted by professional surveyors as the best available evidence of the position of the original corner.

C. Description of monument for corner and accessories established to perpetuate locating the position of the corner:

- F-13 Standard Kent County Monument
- Nail & K.C. remon. tag on N side 10" Walnut S 55° W 104.62'
 - Nail & K.C. remon. tag on S side 26" Walnut S 75° W 111.35'
 - Nail & K.C. remon. tag on S side 14" Maple N 75° W 60.45'
 - Nail & K.C. remon. tag on N side P. pole N 75° W 83.08'
 - SW cor. hse. fndn. N 30° E 167.95'
 - Nail & K.C. remon. tag on S side 34" Walnut N 65° E 64.31'
 - NW cor. conc. bldg. S 30° E 98.16'

Signed by Randy J. Kolehouse Date 7/23/96
 EARTH TECH

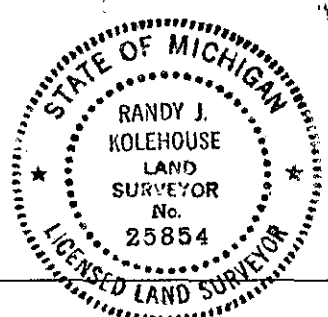

Surveyor's Michigan License No. 25854