

SURVEY & REMONUMENTATION

FEB 14 1997

LAND CORNER RECORDATION CERTIFICATE
Filing Requirement of Act 74, Mich. P.A. 1970
KENT COUNTY REMONUMENTATION

For corners in

COMMISSION

Kent (County)	Located in:	Gaines Township	Corner Code #
1. Public Land Survey	T <u>5N</u>	R <u>11W</u>	<u>G-1</u>
	T _____	R _____	_____
	T _____	R _____	_____
	T _____	R _____	_____
2. Property Controlling in Section	S _____	T _____	R _____
	S _____	T _____	R _____
3. Miscellaneous Property in Sec.	S _____	T _____	R _____
	S _____	T _____	R _____

STATE OF MICHIGAN
 COUNTY OF KENT
 RECEIVED FOR RECORD


96 AUG -8 AM 8:44

REG. OF DEEDS
Lucy [Signature]
9268

Register of Deeds Stamp & File Number

4. Lot No. _____, Recorded Plat _____
 5. Private Claims _____

I, Randy Kolehouse, in a field survey on January 3 19 96, do hereby certify that under requirements of P.A. 74 Michigan P.A. of 1970, the corner points mentioned in lines 1 and 2 above were in conformance with regulations and rules therefore as required in the current manual of survey instructions of the United States Department of the interior, Bureau of Land Management or by a decree of a Court of Law and/or that the corner points mentioned in lines 3, 4 and 5 above were in conformance with the rules of the Michigan Board of Land Surveyors or by a Decree of a Court of Law; established, re-established, monumented, re-monumented, recovered, found as expressed below:

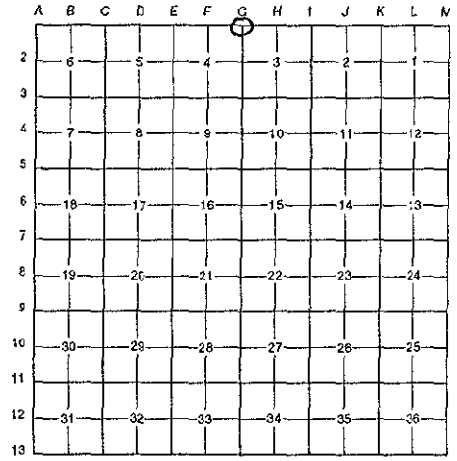

NOTE: Not more than 4 corners, all in the same town and range, may be recorded on this certificate.

A. Description of original monument and accessories and/or subsequent restoration:

G-1	1831	G.L.O. Notes	Mullett	Set Post	P.A. 345 1990 KENT COUNTY
	1943	Witness Map	K.C. Surveyor	Stone	PEER APPROVED <u>3/17/96</u>
	1976	L.C.R.C. #1000	Medema, Van Kooten & Assoc.	1-1/2" Iron	CHAIRMAN <u>[Signature]</u>
	1983	L.C.R.C. #3472	William Byl	Fnd. 1 1/2" Iron in Mon. Box / Set K.C. Monument	
	1992	L.C.R.C. #6547	J. Bueche	K.C. Monument	

Note: This corner is not common with G-13, T6N, R11W.

This corner was originally approved by the Kent County Remonumentation Peer Group and monumented by William Byl on 7/21/83 and was recorded per L.C.R.C. #3472.

B. Description of corner evidence found and/or method applied in restoring or reestablishing corner:

G-1 Found a Standard Kent County Monument on the C/L of 60th Street (bit.) running E & W on line of fence and tree row running South, 10' East of fence and tree row running North, 10.34' East of K.C. Monument at G-13, T6N, R11W, per L.C.R.C.'s #3472 and #6547, as set by William Byl in place of 1-1/2" Iron and monument box he found which checked L.C.R.C. #1000 and K.C. Surveyor's records.

L.C.R.C. #3472

L.C.R.C. #6547

SE cor. gar. (brick) Hse. #2387 N-40-W 109.01'

SE cor. garg. (brick hse. #2387 N 40° W 109.01' (m. 108.92')
 PK E side 10" Elm S 15° E 55.37' (m. 55.39')
 NE cor. conc. headwall N 60° W 51.06' (m. 51.04')
 SE cor. conc. headwall S 65° W 48.81' (m. 48.85')
 SW cor. hse. #2387 (brick) N 60° W 169.83' (m. 169.78')
 K.C. Mon. SE 33, 6-11 West 10.34'
 On C/L bit. E-W

The selected location is accepted by me and is generally accepted by professional surveyors as the best available evidence of the position of the original corner.

C. Description of monument for corner and accessories established to perpetuate locating the position of the corner:

G-1 Standard Kent County Monument

SE cor. garg. (brick hse. #2387 N 40° W 108.92')
 PK E side 10" Elm S 15° E 55.39'
 NE cor. conc. headwall N 60° W 51.04'
 SE cor. conc. headwall S 65° W 48.85'

SW cor. hse. #2387 (brick) N 60° W 169.78'
 K.C. Mon. SE 33, T6N, R11W, West 10.34'
 On C/L bit. E-W

Signed by Randy J. Kolehouse
 EARTH TECH

Date 7/23/96

Surveyor's Michigan License No. 25854

