

**SURVEY & REMONUMENTATION**

FEB 14 1997

COMMISSION

**LAND CORNER RECORDATION CERTIFICATE**  
**Filing Requirement of Act 74, Mich. P.A. 1970**  
**KENT COUNTY REMONUMENTATION**

For corners in

Kent (County)	Located in:	Gaines Township	Corner Code #
1. Public Land Survey	T <u>5N</u>	R <u>11W</u>	<u>G-2</u>
	T _____	R _____	_____
	T _____	R _____	_____
	T _____	R _____	_____
2. Property Controlling in Section	S _____	T _____	R _____
	S _____	T _____	R _____
3. Miscellaneous Property in Sec.	S _____	T _____	R _____
	S _____	T _____	R _____

STATE OF MICHIGAN  
 COUNTY OF KENT  
 RECEIVED FOR RECORD

96 AUG -8 AM 8:44

REG. OF DEEDS

*W. J. ...*

9264

Register of Deeds Stamp & File Number

4. Lot No. \_\_\_\_\_, Recorded Plat \_\_\_\_\_  
 5. Private Claims \_\_\_\_\_

I, Randy Kolehouse, in a field survey on December 29 19 95, do hereby certify that under requirements of P.A. 74 Michigan P.A. of 1970, the corner points mentioned in lines 1 and 2 above were in conformance with regulations and rules therefore as required in the current manual of survey instructions of the United States Department of the interior, Bureau of Land Management or by a decree of a Court of Law and/or that the corner points mentioned in lines 3, 4 and 5 above were in conformance with the rules of the Michigan Board of Land Surveyors or by a Decree of a Court of Law; established, re-established, monumented, re-monumented, recovered, found as expressed below:

**NOTE: Not more than 4 corners, all in the same town and range, may be recorded on this certificate.**

	A	B	C	D	E	F	G	H	I	J	K	L	N
2	6	5	4	3	2	1							
3													
4	7	8	9	10	11	12							
5													
6	18	17	16	15	14	13							
7													
8	19	20	21	22	23	24							
9													
10	30	29	28	27	26	25							
11													
12	31	32	33	34	35	36							
13													

A. Description of original monument and accessories and/or subsequent restoration:

G-2	1831	G.L.O. Notes	Mullett	Set Post
	N/A	Witness Map	K.C. Surveyor	Stake
	1978	L.C.R.C. #1217	Exxel Engineering	1/2" Iron
	1982	L.C.R.C. #2823	Jonker Land Surveys	Fnd. 1/2" iron / Set K.C. Monument
	1989	L.C.R.C. #5050	J. Bueche	K.C. Monument

P.A. 345 1990 KENT COUNTY  
 PEER APPROVED 3/7/96  
 CHAIRMAN Harry Hubert

This corner was originally approved by the Kent County Remonumentation Peer Group and monumented by Jonker Land Surveys on 4/14/82 and was recorded per L.C.R.C. #2823.

B. Description of corner evidence found and/or method applied in restoring or reestablishing corner:

G-2 Found a Standard Kent County Monument at intersection of tree rows to S & E per L.C.R.C.'s #2823 and #5050 as set by Jonker Land Surveys in place of a 1/2" iron they found which checked L.C.R.C. #1217 and K.C. Surveyor's records.

L.C.R.C. #2823

L.C.R.C. #5050

Remon. tag on N side 12" Elm N 90° E 52.39'  
 Remon. tag on SE side 36" Ash N 40° E 6.28'


Nail & Remon on N side 14" Elm N 90° E 52.39' (m. 52.45')  
 Nail & Remon on SE side 48" Ash N 40° E 6.28'

The selected location is accepted by me and is generally accepted by professional surveyors as the best available evidence of the position of the original corner.

C. Description of monument for corner and accessories established to perpetuate locating the position of the corner:

G-2 Standard Kent County Monument

- Nail & K.C. remon. tag on SE side 48" Ash N 40° E 6.28'
- Nail & K.C. remon. tag on W side 8" Clump Ash S 05° W 64.06'
- Nail & K.C. remon. tag on N side 8" Ash N 80° E 33.95'
- Nail & K.C. remon. tag on N side 18" Ash N 90° E 52.45'

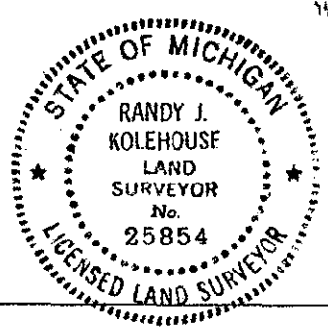

Signed by Randy J. Kolehouse  
 EARTH TECH

Date 7/23/96

Surveyor's Michigan License No. 25854