

SURVEY & REMONUMENTATION

FEB 14 1997

COMMISSION

LAND CORNER RECORDATION CERTIFICATE
Filing Requirement of Act 74, Mich. P.A. 1970
KENT COUNTY REMONUMENTATION

For corners in

Kent (County)	Located in: Gains Township	Corner Code #
1. Public Land Survey	T <u>5N</u> R <u>11W</u>	<u>G-3</u>
	T _____ R _____	_____
	T _____ R _____	_____
	T _____ R _____	_____
2. Property Controlling in Section	S _____ T _____ R _____	_____
	S _____ T _____ R _____	_____
3. Miscellaneous Property in Sec.	S _____ T _____ R _____	_____
	S _____ T _____ R _____	_____


STATE OF MICHIGAN
 COUNTY OF KENT
 RECEIVED FOR RECORD

96 AUG -8 AM 8:44

REG. OF DEEDS
9265

Register of Deeds Stamp & File Number

4. Lot No. _____, Recorded Plat _____
 5. Private Claims _____

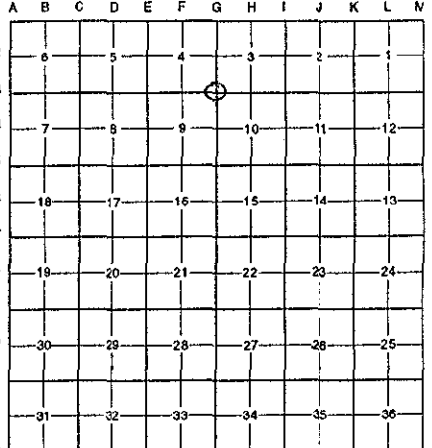

I, Randy Kolehouse, in a field survey on June 29 19 96, do hereby certify that under requirements of P.A. 74 Michigan P.A. of 1970, the corner points mentioned in lines 1 and 2 above were in conformance with regulations and rules therefore as required in the current manual of survey instructions of the United States Department of the interior, Bureau of Land Management or by a decree of a Court of Law and/or that the corner points mentioned in lines 3, 4 and 5 above were in conformance with the rules of the Michigan Board of Land Surveyors or by a Decree of a Court of Law; established, re-established, monumented, re-monumented, recovered, found as expressed below:

NOTE: Not more than 4 corners, all in the same town and range, may be recorded on this certificate.

A. Description of original monument and accessories and/or subsequent restoration:

G-3	1831	G.L.O. Notes	Mullett	Set Post
	1959	Witness Map	K.C. Surveyor	Hub on Stone
	1972	L.C.R.C. #171	F.E. Spicer	Iron in Monument Box
	1982	L.C.R.C. #2824	Jonker Land Surveys	Fnd. Iron in Mon. Box / Set K.C. Monument in Mon. Box
	1989	L.C.R.C. #5051	J. Bueche	K.C. Monument in Mon. Box

P.A. 345 1990 KENT COUNTY
 PEER APPROVED 3/7/96
 CHAIRMAN Randy Kolehouse

This corner was originally approved by the Kent County Remonumentation Peer Group and monumented by Rob Jonker on 4/14/82 and was recorded per L.C.R.C. #2824.


B. Description of corner evidence found and/or method applied in restoring or reestablishing corner:
 G-3 Found a Standard Kent County Monument in the C/L of 68th Street (bit.) running East and West on line of tree row running North per L.C.R.C.'s #2824 and #5051 as set by Rob Jonker in place of an iron he found which checked L.C.R.C. #171 and the K.C. Surveyor's records.

L.C.R.C. #2824	L.C.R.C. #5051
Remon. tag on N side p. pole S 75° E 103.05'	Nail & Remon. Tag on N side P. pole S 75° E 102.75'
U.S.G.S. BM (C/L) N 00° W 37.51'	U.S.G.S. BM (C/L) N 00° W 37.51' (m. 47.57')
SE Cor. hse. brick N 45° E 135.44'	SE corner house brick N 45° E 135.44'
On line fence & tree line to N & C/L E-W pavement	On line fence & tree line to N & on C/L blacktop E-W

The selected location is accepted by me and is generally accepted by professional surveyors as the best available evidence of the position of the original corner.

C. Description of monument for corner and accessories established to perpetuate locating the position of the corner:
 G-3 Standard Kent County Monument

Nail & K.C. remon. tag on W side 16" Hickory N 01° W 71.76'
 U.S.G.S. BM N 00° W 47.57'
 SE cor. brick hse. N 45° E 135.44'
 Nail & K.C. remon. tag on N side P. pole S 75° E 102.75'

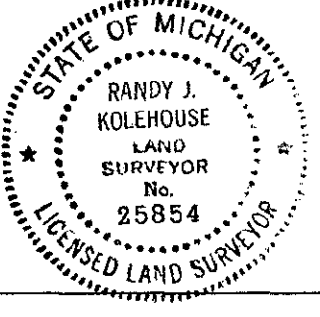

Signed by Randy J. Kolehouse Date 7/23/96
 EARTH TECH
 Surveyor's Michigan License No. 25854