

SURVEY & REMONUMENTATION

FEB 14 1997

COMMISSION

LAND CORNER RECORDATION CERTIFICATE
Filing Requirement of Act 74, Mich. P.A. 1970
KENT COUNTY REMONUMENTATION

For corners in

Kent (County)	Located in: Gains Township	Corner Code #
1. Public Land Survey	T <u>5N</u> R <u>11W</u>	<u>G-4</u>
	T _____ R _____	_____
	T _____ R _____	_____
	T _____ R _____	_____
2. Property Controlling in Section	S _____ T _____ R _____	_____
	S _____ T _____ R _____	_____
3. Miscellaneous Property in Sec.	S _____ T _____ R _____	_____
	S _____ T _____ R _____	_____

REG. OF DEEDS

9266


Register of Deeds Stamp & File Number

STATE OF MICHIGAN
 COUNTY OF KENT
 RECEIVED FOR RECORD
 96 AUG -8 AM 8:44

4. Lot No. _____, Recorded Plat _____
 5. Private Claims _____

I, Randy Kolehouse, in a field survey on January 17 19 96, do hereby certify that under requirements of P.A. 74 Michigan P.A. of 1970, the corner points mentioned in lines 1 and 2 above were in conformance with regulations and rules therefore as required in the current manual of survey instructions of the United States Department of the interior, Bureau of Land Management or by a decree of a Court of Law and/or that the corner points mentioned in lines 3, 4 and 5 above were in conformance with the rules of the Michigan Board of Land Surveyors or by a Decree of a Court of Law; established, re-established, monumented, re-monumented, recovered, found as expressed below:

NOTE: Not more than 4 corners, all in the same town and range, may be recorded on this certificate.

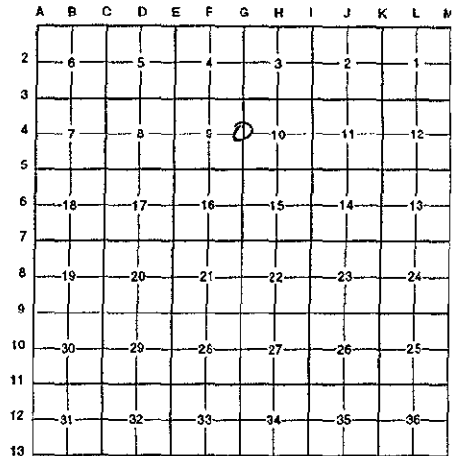

A. Description of original monument and accessories and/or subsequent restoration:

G-4	1831	G.L.O. Notes	Mullett	Set Post
	N/A	Witness Map	K.C. Surveyor	SW Side 15" Fence Post
	1972	L.C.R.C. #166	Medema, Van Kooten & Assoc.	Iron in Concrete
	1982	L.C.R.C. #2825	Jonker Land Surveys	3/4" Iron in 30" dia. Conc. / Set K.C. Monument
	1989	L.C.R.C. #5052	J. Bueche	3/4" Iron in 30"

P.A. 345 1990 KENT COUNTY

PEER APPROVED 3/2/96
 CHAIRMAN Randy Kolehouse

This corner was originally approved by the Kent County Remonumentation Peer Group and monumented by Rob Jonker on 4/14/82 and was recorded per L.C.R.C. #2825.

B. Description of corner evidence found and/or method applied in restoring or reestablishing corner:

G-4 Found a 3/4" Iron in a 30" dia. concrete base to a rail road rail fence post for fence lines running East, West and South, 80' M/L South of Consumers Power Company line running East and West, per L.C.R.C.'s #166, #2825 and #5052 and also checks K.C. Surveyor's records.

L.C.R.C. #2825

L.C.R.C. #5052

Remon. tag on S side 12" Ash S 85° W 27.48'
 Remon. tag on S side P. pole N 00° E 71.85'
 Remon. tag on E side 6" Elm S 15° W 32.84'
 Face railroad rail fence corner post E. 0.3'
 C/L E-W power line is N 80' m/l
 At fence corner to E, S, W

Nail & Remon Tag on S side 16" Ash S 85° W 27.48'
 Nail & Remon Tag on E side p. pole N 0° E 71.85'
 New Nail & Remon Tag on E side 8" Elm S 15° W 32.93' (m. 32.95')
 Nail & Remon Tag on N side S 60° E 12.95'
 Face railroad rail fence corner post E 0.3'
 C/L E-W power line is N 80' ±
 At fence corner to E, S, W

The selected location is accepted by me and is generally accepted by professional surveyors as the best available evidence of the position of the original corner.

C. Description of monument for corner and accessories established to perpetuate locating the position of the corner:

G-4 3/4" Iron in Concrete to Rail Fence Post

Nail & K.C. remon. tag on S side 16" Ash S 85° W 27.48'
 Nail & K.C. remon. tag on E side P. pole N 00° W 71.85'
 Nail & K.C. remon. tag on E side 8" Elm S 15° W 32.95'
 Nail & K.C. remon. tag on N side 5" Elm S 60° E 12.95'
 Face RR rail fence cor. post East 0.3'

Signed by Randy J. Kolehouse

Date 7/23/96

EARTH TECH

Surveyor's Michigan License No. 25854

