

**SURVEY &
REMONUMENTATION**

FEB 14 1997

COMMISSION

**LAND CORNER RECORDATION CERTIFICATE
Filing Requirement of Act 74, Mich. P.A. 1970
KENT COUNTY REMONUMENTATION**

For corners in

<u>Kent</u> (County)	Located in: <u>Gaines</u> Township	Corner Code #	
1. Public Land Survey	T <u>5N</u> R <u>11W</u>	<u>G-6</u>	
	T _____ R _____	_____	_____
	T _____ R _____	_____	_____
	T _____ R _____	_____	_____
2. Property Controlling in Section	S _____ T _____ R _____	_____	_____
	S _____ T _____ R _____	_____	_____
3. Miscellaneous Property in Sec.	S _____ T _____ R _____	_____	_____
	S _____ T _____ R _____	_____	_____

REG. OF DEEDS

Lucy Sand


STATE OF MICHIGAN
COUNTY OF KENT
RECEIVED FOR RECORD
96 AUG -8 AM 8:44

9268

Register of Deeds Stamp & File Number

4. Lot No. _____, Recorded Plat _____
5. Private Claims _____

I, Randy Kolehouse, in a field survey on December 29 19 95, do hereby certify that under requirements of P.A. 74 Michigan P.A. of 1970, the corner points mentioned in lines 1 and 2 above were in conformance with regulations and rules therefore as required in the current manual of survey instructions of the United States Department of the Interior, Bureau of Land Management or by a decree of a Court of Law and/or that the corner points mentioned in lines 3, 4 and 5 above were in conformance with the rules of the Michigan Board of Land Surveyors or by a Decree of a Court of Law; established, re-established, monumented, re-monumented, recovered, found as expressed below:

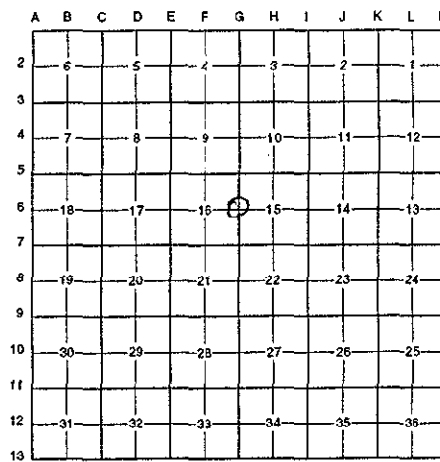

NOTE: Not more than 4 corners, all in the same town and range, may be recorded on this certificate.

A. Description of original monument and accessories and/or subsequent restoration:

G-6	1831	G.L.O. Notes	Mullett	Set Post
	1975	L.C.R.C. #808	Exxel Engineering	1 1/2" Iron
	1980	L.C.R.C. #1797	William Byl	Fnd. 1 1/2" Iron / Set K.C. Monument
	1989	L.C.R.C. #5054	J. Bueche	K.C. Monument

P.A. 345 1990 KENT COUNTY
PEER APPROVED 3/7/96
CHAIRMAN Harry Pugh

This corner was originally approved by the Kent County Remonumentation Peer Group and monumented by William Byl on 12/17/80 and was recorded per L.C.R.C. #1797.

B. Description of corner evidence found and/or method applied in restoring or reestablishing corner:

G-6 Found a Standard Kent County Monument on C/L or Breton Avenue (bit.) running N-S on line of a fence line running East as set by William Byl in place of a 1 1/2" iron he found that checked L.C.R.C. #808.

L.C.R.C. #1797	L.C.R.C. #5054
NE cor. hse fdn. S 75° W 87.25'	NE corner house fdn. S 75° W 87.25'
Nail & tag, N side Transformer pole W 54.02' (m. 64.02')	Nail & Remon. Tag N side transformer pole W 64.02'
Nail & tag, N side MBT pole E 26.00'	Nail & Remon. Tag N side pole E 26.22'
Nail & tag, E side 28" Maple S 30° W 54.97'	Nail & Remon. Tag E side 32" Maple S 30° W 54.97'
	Nail & Remon. Tag W side p. pole N 20° E 169.10'
	Nail & Remon. Tag N side 10" x 10" fence post N 05° E 25.45'

The selected location is accepted by me and is generally accepted by professional surveyors as the best available evidence of the position of the original corner.

C. Description of monument for corner and accessories established to perpetuate locating the position of the corner:

- G-6 Standard Kent County Monument
- Nail & K.C. remon. tag on N side Transformer pole West 64.02'
 - NE cor. hse. fdn. S 75° W 87.25'
 - Nail & K.C. remon. tag on E side 28" Maple S 30° W 54.97'
 - Nail & K.C. remon. tag on N side 10' x 10' wood fence post East N 05° E 25.72'
 - Nail & K.C. remon. tag on W side P. pole N 20° E 169.10'
 - Nail & K.C. remon. tag on S side 14" Ash S 70° W 29.9'



Signed by Randy J. Kolehouse Date 7/23/96
EARTH TECH

Surveyor's Michigan License No. 25854