

SURVEY & REMONUMENTATION

FEB 14 1997

COMMISSION

LAND CORNER RECORDATION CERTIFICATE
Filing Requirement of Act 74, Mich. P.A. 1970
KENT COUNTY REMONUMENTATION

For corners in

Kent (County)	Located in: Gaines Township	Corner Code #
1. Public Land Survey	T <u>5N</u> R <u>11W</u>	<u>G-7</u>
	T _____ R _____	_____
	T _____ R _____	_____
	T _____ R _____	_____
2. Property Controlling in Section	S _____ T _____ R _____	_____
	S _____ T _____ R _____	_____
3. Miscellaneous Property in Sec.	S _____ T _____ R _____	_____
	S _____ T _____ R _____	_____

STATE OF MICHIGAN
COUNTY OF KENT
RECEIVED FOR RECORD

96 AUG -8 AM 8:44

REG. OF DEEDS
Lucy Bond


9269

Register of Deeds Stamp & File Number

4. Lot No. _____, Recorded Plat _____
5. Private Claims _____

I, Randy Kolehouse, in a field survey on January 2 19 96, do hereby certify that under requirements of P.A. 74 Michigan P.A. of 1970, the corner points mentioned in lines 1 and 2 above were in conformance with regulations and rules therefore as required in the current manual of survey instructions of the United States Department of the interior, Bureau of Land Management or by a decree of a Court of Law and/or that the corner points mentioned in lines 3, 4 and 5 above were in conformance with the rules of the Michigan Board of Land Surveyors or by a Decree of a Court of Law; established, re-established, monumented, re-monumented, recovered, found as expressed below:

NOTE: Not more than 4 corners, all in the same town and range, may be recorded on this certificate.

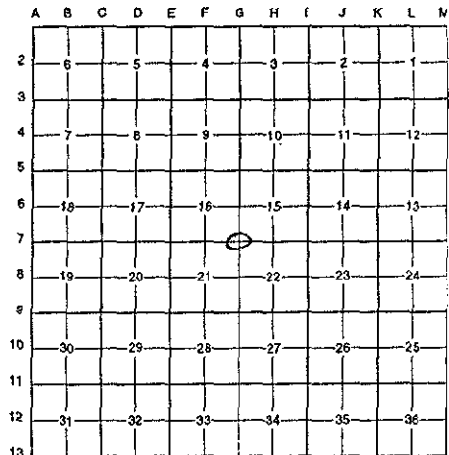

A. Description of original monument and accessories and/or subsequent restoration:

G-7	1831	G.L.O. Notes	Mullett	Set Post	P.A. 345 1990 KENT COUNTY
	1914-1960	Witness Map	K.C. Surveyor	2" Iron	PEER APPROVED 3/7/96
	1914-1960	Survey Records	Williams & Works	2" Iron	CHAIRMAN <i>Randy Kolehouse</i>
	1974	L.C.R.C. #719	Nederveld	1" Iron in Mon. Box	
	1974	L.C.R.C. #720	Medema, Van Kooten & Assoc.	1" Iron in Mon. Box	
	1981	L.C.R.C. #1801	William Byl	Fnd. 1" Iron in Mon. Box / set*	
	1989	L.C.R.C. #L.C.R.C. #000	J. Bueche	K.C. Monument	

This corner was originally approved by the Kent County Remonumentation Peer Group and monumented by William Byl on 2/23/81 and was recorded per L.C.R.C. #1801.

B. Description of corner evidence found and/or method applied in restoring or reestablishing corner:


G-7 Found a Standard Kent County Monument in a monument box on the C/L of 84th Street (bit.) running E & W and Breton Avenue (gravel) running South and 6' M/L West of the C/L of Breton Avenue (bit.) running North per L.C.R.C.'s #1801 and #5055 as set by William Byl in place of a 1" iron in a monument box he found which checked L.C.R.C.'s #719 and #720 and K.C. Surveyor's records.

L.C.R.C. #1801	L.C.R.C. #5055
SW corner Bldg. fndn. (at ground level) N 65° E 138.62'	SW corner bldg fndn (at ground level) N 65° E 138.62'
Nail & tag, S side CP pole N 50° W 81.60'	Nail & Remon Tag S side CP pole N 50° W 81.60' (m. 81.52')
Nail & tag, W side 12" Ash S 10° E 116.60'	New Nail & Remon Tag W side 16" Ash S 10° E 116.60' (m. 159.98')

The selected location is accepted by me and is generally accepted by professional surveyors as the best available evidence of the position of the original corner.

C. Description of monument for corner and accessories established to perpetuate locating the position of the corner:

- G-7 Standard Kent County Monument in a Monument Box
- Nail & K.C. remon. tag on SE side 14" Maple 129.57'
 - Nail & K.C. remon. tag on SE side 10" Ash 119.54'
 - Nail & K.C. remon. tag on S side CP pole N 50° W 81.52'
 - Nail & K.C. remon. tag on W side 16" Ash S 10° E 116.60'
 - SW cor. bldg. fndn. at ground level N 65° E 159.98'
 - Nail & K.C. remon. tag on W side 14" Ash S 15° E 62.88'

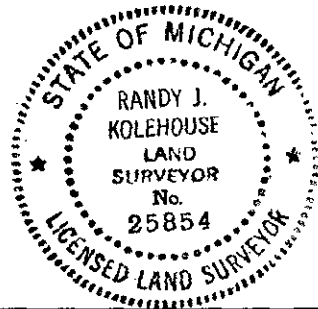

Signed by *Randy J. Kolehouse* Date 7/23/96
EARTH TECH

Surveyor's Michigan License No. 25854