

SURVEY & REMONUMENTATION

FEB 14 1997

COMMISSION

LAND CORNER RECORDATION CERTIFICATE
Filing Requirement of Act 74, Mich. P.A. 1970
KENT COUNTY REMONUMENTATION

For corners in

<u>Kent</u> (County)	Located in: <u>Gaines</u> Township	Corner Code # <u>G-9</u>
1. Public Land Survey	T <u>5N</u> R <u>11W</u>	<u>G-9</u>
	T _____ R _____	_____
	T _____ R _____	_____
	T _____ R _____	_____
2. Property Controlling in Section	S _____ T _____ R _____	_____
	S _____ T _____ R _____	_____
3. Miscellaneous Property in Sec.	S _____ T _____ R _____	_____
	S _____ T _____ R _____	_____

STATE OF MICHIGAN
COUNTY OF KENT
RECEIVED FOR RECORD

95 AUG -8 AM 8:44


REG. OF DEEDS

9271

Register of Deeds Stamp & File Number

4. Lot No. _____, Recorded Plat _____
5. Private Claims _____

I, Randy Kolehouse, in a field survey on January 2 19 96, do hereby certify that under requirements of P.A. 74 Michigan P.A. of 1970, the corner points mentioned in lines 1 and 2 above were in conformance with regulations and rules therefore as required in the current manual of survey instructions of the United States Department of the interior, Bureau of Land Management or by a decree of a Court of Law and/or that the corner points mentioned in lines 3, 4 and 5 above were in conformance with the rules of the Michigan Board of Land Surveyors or by a Decree of a Court of Law; established, re-established, monumented, re-monumented, recovered, found as expressed below:

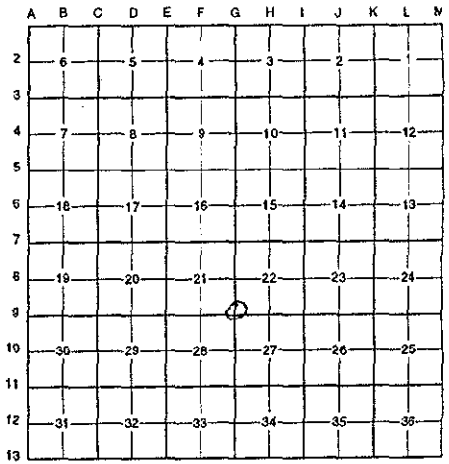

NOTE: Not more than 4 corners, all in the same town and range, may be recorded on this certificate.

A. Description of original monument and accessories and/or subsequent restoration:

G-9	1831	G.L.O. Notes	Mullet	Set Post	P.A. 345 1990 KENT COUNTY
	1913	Survey Records	Williams & Works	Iron	PEER APPROVED 3/7/96
	1966	Witness Map	K.C. Surveyor	Iron	CHAIRMAN <u>Harry Hueber</u>
	1973	L.C.R.C. #600	Medema, Van Kooten & Assoc.	"T" Iron	
	1981	L.C.R.C. #1804	William Byl	Fnd. "T" Iron / Set K.C. Monument	
	1989	L.C.R.C. #5057	J. Bueche	K.C. Monument	

This corner was originally approved by the Kent County Remonumentation Peer Group and monumented by William Byl on 2/24/81 and was recorded per L.C.R.C. #1804.

B. Description of corner evidence found and/or method applied in restoring or reestablishing corner:

G-9 Found a Standard Kent County Monument 1' M/L South of the C/L of 92nd Street (bit.) running E & W per L.C.R.C.'s #1804 and #5057 as set by William Byl in place of a "T" iron he found which checked L.C.R.C. #600 and Williams & Works' survey records.

L.C.R.C. #1804	L.C.R.C. #5057
Nail & tag, N side 14" Maple S 75° W 92.10'	New Nail & Remon Tag N. side 18" Maple S 75° W 92.10' (m. 92.08')
Nail & tag, N side Power Pole S 60° E 196.65'	Nail & Remon Tag N side p. pole S 60° E 196.65'
	Nail & Remon Tag W side 8" Apple S 30° E 29.32' (m. 29.30')


The selected location is accepted by me and is generally accepted by professional surveyors as the best available evidence of the position of the original corner.

C. Description of monument for corner and accessories established to perpetuate locating the position of the corner:

- G-9 Standard Kent County Monument
- Nail & K.C. remon. tag on N side P. pole S 60° E 198.11' (new pole)
 - Nail & K.C. remon. tag on W side 8" Apple S 30° E 29.30'
 - Nail & K.C. remon. tag on N side 18" Maple S 75° W 92.08'
 - Nail & K.C. remon. tag on SW side Guy pole N 25° W 29.10'

Signed by Randy J. Kolehouse
 EARTH TECH

Date 7/23/96

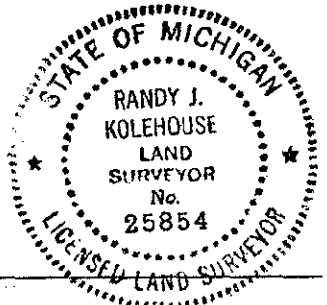

Surveyor's Michigan License No. 25854