

**SURVEY & REMONUMENTATION**

FEB 14 1997

**COMMISSION**

**LAND CORNER RECORDATION CERTIFICATE**  
**Filing Requirement of Act 74, Mich. P.A. 1970**  
**KENT COUNTY REMONUMENTATION**

For corners in

<u>Kent</u> (County)	Located in:	Gaines Township	Corner Code #
1. Public Land Survey	T <u>5N</u>	R <u>11W</u>	<u>G-10</u>
	T _____	R _____	_____
	T _____	R _____	_____
	T _____	R _____	_____
2. Property Controlling in Section	S _____	T _____	R _____
	S _____	T _____	R _____
3. Miscellaneous Property in Sec.	S _____	T _____	R _____
	S _____	T _____	R _____

STATE OF MICHIGAN  
 COUNTY OF KENT  
 RECEIVED FOR RECORD  
 96 AUG -8 AM 8:44  
 REG. OF DEEDS  
*Lucy Stand*

**9272**

Register of Deeds Stamp & File Number

4. Lot No. \_\_\_\_\_, Recorded Plat \_\_\_\_\_  
 5. Private Claims \_\_\_\_\_

I, Randy Kolehouse, in a field survey on January 3 19 96, do hereby certify that under requirements of P.A. 74 Michigan P.A. of 1970, the corner points mentioned in lines 1 and 2 above were in conformance with regulations and rules therefore as required in the current manual of survey instructions of the United States Department of the interior, Bureau of Land Management or by a decree of a Court of Law and/or that the corner points mentioned in lines 3, 4 and 5 above were in conformance with the rules of the Michigan Board of Land Surveyors or by a Decree of a Court of Law; established, re-established, monumented, re-monumented, recovered, found as expressed below:

A	B	C	D	E	F	G	H	I	J	K	L	M
2	6	5	4	3	2	1						
3												
4	7	8	9	10	11	12						
5												
6	16	17	18	15	14	13						
7												
8	19	20	21	22	23	24						
9												
10	30	29	28	27	26	25						
11												
12	31	32	33	34	35	36						
13												

**NOTE: Not more than 4 corners, all in the same town and range, may be recorded on this certificate.**

**A. Description of original monument and accessories and/or subsequent restoration:**

G-10	1831	G.L.O. Notes	Mullett	Set Post
	N/A	Witness Map	K.C. Surveyor	Capped Iron
	1973	L.C.R.C. #600	Medema, Van Kooten & Assoc.	Set Capped Iron
	1982	L.C.R.C. #2826	Jonker Land Surveys	Fnd. Capped Iron / Set K.C. Monument
	1989	L.C.R.C. #5058	J. Bueche	K.C. Monument

P.A. 345 1990 KENT COUNTY  
 PEER APPROVED 3/7/96  
 CHAIRMAN *Harry Huber*

This corner was originally approved by the Kent County Remonumentation Peer Group and monumented by Rob Jonker on 4/27/82 and was recorded per L.C.R.C. #2826.

**B. Description of corner evidence found and/or method applied in restoring or reestablishing corner:**

G-10 Found a Standard Kent County Monument at a fence corner of fences running North and South and East as set by Rob Jonker in place of a capped iron set by Medema, Van Kooten & Assoc. This corner checks L.C.R.C. #600.

L.C.R.C. #2826

L.C.R.C. #5028

Remon. tag on E side 16" Beech N 10° W 13.58'  
 Remon. tag on W side 24" Oak S 05° E 12.19'  
 Remon. tag on SW side 8" Maple S 50° E 26.79'  
 Remon. tag on N side 12" Beech East 1.32'  
 Remon. tag on S side 8" Beech N 55° W 3.04'


Nail & Remon. Tag on E side 24" Beech N 10° W 13.58'  
 Nail & Remon. Tag on W side 30" Oak S 05° E 12.25'  
 Nail & Remon. Tag on SW side 10" Maple S 50° E 26.80'  
 Nail & Remon Tag on N side 16" Beech East 1.50'  
 Nail & Remon. Tag on S side 10" Beech N 55° W 3.04'

The selected location is accepted by me and is generally accepted by professional surveyors as the best available evidence of the position of the original corner.

**C. Description of monument for corner and accessories established to perpetuate locating the position of the corner:**

G-10 Standard Kent County Monument

Nail & K.C. remon. tag on E side 24" Beech N 10° W 13.58'  
 Nail & K.C. remon. tag on W side 30" Oak S 05° E 12.25'  
 Nail & K.C. remon. tag on SW side 10" Maple S 50° E 26.80'  
 Nail & K.C. remon. tag on N side 16" Beech East 1.50'  
 Nail & K.C. remon. tag on S side 10" Beech N 55W 3.04'

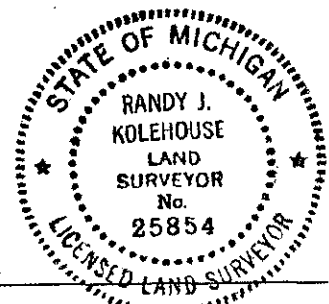

Signed by *Randy J. Kolehouse*  
 EARTH TECH

Date 7/23/96

Surveyor's Michigan License No. 25854