

**SURVEY & REMONUMENTATION**

FEB 14 1997

**COMMISSION**


**LAND CORNER RECORDATION CERTIFICATE**  
**Filing Requirement of Act 74, Mich. P.A. 1970**  
**KENT COUNTY REMONUMENTATION**

For corners in

<u>Kent</u> (County)	Located in: <u>Gaines</u> Township	Corner Code #
1. Public Land Survey	T <u>5N</u> R <u>11W</u>	<u>G-11</u>
	T _____ R _____	_____
	T _____ R _____	_____
	T _____ R _____	_____
2. Property Controlling in Section	S _____ T _____ R _____	_____
	S _____ T _____ R _____	_____
3. Miscellaneous Property in Sec.	S _____ T _____ R _____	_____
	S _____ T _____ R _____	_____
4. Lot No. _____, Recorded Plat _____		
5. Private Claims _____		

STATE OF MICHIGAN  
 COUNTY OF KENT  
 RECEIVED FOR RECORD  
 96 AUG -8 AM 8:44  
 REG. OF DEEDS  
*Lucy S. [Signature]*  
**9273**  
 Register of Deeds Stamp & File Number

I, Randy Kolehouse, in a field survey on January 25 19 96, do hereby certify that under requirements of P.A. 74 Michigan P.A. of 1970, the corner points mentioned in lines 1 and 2 above were in conformance with regulations and rules therefore as required in the current manual of survey instructions of the United States Department of the interior, Bureau of Land Management or by a decree of a Court of Law and/or that the corner points mentioned in lines 3, 4 and 5 above were in conformance with the rules of the Michigan Board of Land Surveyors or by a Decree of a Court of Law; established, re-established, monumented, re-monumented, recovered, found as expressed below:

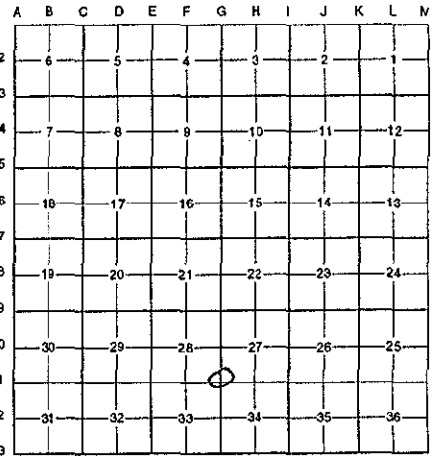

**NOTE: Not more than 4 corners, all in the same town and range, may be recorded on this certificate.**

**A. Description of original monument and accessories and/or subsequent restoration:**

G-11	1831	G.L.O. Notes	Mullett	Set Post
	1953	Witness Map	K.C. Surveyor	3/4" Iron in Mon. Box
	1973	L.C.R.C. #641	Exxel Engineering	1/2" Iron in Mon. Box
	1982	L.C.R.C. #2827	Jonker Land Surveys	Fnd. 1/2" Iron in Mon. Box / Set K.C. Monument in Mon. Box
	1989	L.C.R.C. #5059	J. Bueche	K.C. Monument in Mon. Box

P.A. 345 1990 KENT COUNTY  
 PEER APPROVED 3/6/96  
 CHAIRMAN [Signature]

This corner was originally approved by the Kent County Remonumentation Peer Group and monumented by Jonker Land Surveys on 4/20/82 and was recorded per L.C.R.C. #2827.

**B. Description of corner evidence found and/or method applied in restoring or reestablishing corner:**

G-11 Found a Standard Kent County Monument in monument box on C/L of 100th Street (bit.) running E-W on line of a tree row running North as set by Jonker Land Surveys in place of a 1/2" iron they found in a monument box which checked L.C.R.C. #641 and K.C. Surveyor's records.

L.C.R.C. #2827

L.C.R.C. #5059

Remon. tag on W side p. pole N 00° E 47.71'  
 Remon. tag on W side t. pole S 05° E 30.64'  
 Chiseled "X" on N end concrete culvert N 75° E 100.3'  
 Chiseled "S" on S end concrete culvert S 65° E 103.32'

Nail & Remon Tag on W side p. pole N 00° E 47.71'  
 Nail & Remon Tag on W side t. pole S 05° E 30.64' (m. 30.54')  
 Chised "X" on N end concrete culvert N 75° E 100.3' (m. 100.30')  
 Chiseled "X" on S end concrete culvert S 65° E 103.32' (m. 103.26')

The selected location is accepted by me and is generally accepted by professional surveyors as the best available evidence of the position of the original corner.

**C. Description of monument for corner and accessories established to perpetuate locating the position of the corner:**

G-11 Standard Kent County Monument in a Monument Box

- Nail & K.C. remon. tag on N side 16" Cherry S 80° W 259.63'
- Nail & K.C. remon. tag on W side T. pole S 05° E 30.54'
- "X" on top end conc. culv. S 65° E 103.26'
- "X" on top end conc. culv. N 75° E 100.30'
- Nail & K.C. remon. tag on W side P. pole N 00° E 47.71'



Signed by Randy J. Kolehouse  
 EARTH TECH

Date 7/23/96

Surveyor's Michigan License No. 25854