

FEB 14 1997

COMMISSION

LAND CORNER RECORDATION CERTIFICATE
Filing Requirement of Act 74, Mich. P.A. 1970
KENT COUNTY REMONUMENTATION

For corners in

Table with columns: Kent (County), Located in: Gains Township, Corner Code #. Rows include Public Land Survey, Property Controlling in Section, and Miscellaneous Property in Sec.

4. Lot No. \_\_\_\_\_, Recorded Plat \_\_\_\_\_
5. Private Claims \_\_\_\_\_

I, Randy Kolehouse, in a field survey on January 17, 1996, do hereby certify that under requirements of P.A. 74 Michigan P.A. of 1970, the corner points mentioned in lines 1 and 2 above were in conformance with regulations and rules therefore as required in the current manual of survey instructions of the United States Department of the interior, Bureau of Land Management or by a decree of a Court of Law and/or that the corner points mentioned in lines 3, 4 and 5 above were in conformance with the rules of the Michigan Board of Land Surveyors or by a Decree of a Court of Law; established, re-established, monumented, re-monumented, recovered, found as expressed below:

NOTE: Not more than 4 corners, all in the same town and range, may be recorded on this certificate.

A. Description of original monument and accessories and/or subsequent restoration:

Table with columns: G-12, 1831, G.L.O. Notes, Mullett, Set Post, 1904, Survey Notes, Williams & Works, Fence Intersection, 1967, Wit. Map, K.C. Road Commission, 3/4" Iron, 1983, L.C.R.C. #3394, William Byl, Fnd. 3/4" Iron / Set K.C. Monument, 1989, L.C.R.C. #5060, J. Bueche, K.C. Monument

This corner was originally approved by the Kent County Remonumentation Peer Group and monumented by William Byl on 4/21/83 and was recorded per L.C.R.C. #3394.

B. Description of corner evidence found and/or method applied in restoring or reestablishing corner:

G-12 Found a Standard Kent County Monument in rock pile at intersection of fences running North, South, West and East as set by William Byl to replaced 3/4" iron he found which checked K.C. Surveyor's records.

L.C.R.C. #3394

- Nail & tag, N sd. 36" Maple N 60 E 9.85'
Nail & tag, S sd. 8" Ash N 85 E 46.70'
Nail & tag, S sd. 4" Ash N 85 W 23.20' (New - m. 23.11')
Nail & tag, E sd. 30" Cherry N 15 E 31.72'

L.C.R.C. #5060

- K.C. Monument in stone pile
Nail & Remon Tag N side 40" Maple N 60° E 9.85'
Nail & Remon Tag S side 6" Ash N 85° W 23.20' (m. 23.11')
Nail & Remon Tag S side 10" Ash N 85° E 46.70'
Nail & Remon Tag E side 32" Cherry N 15° E 31.72' on field division South fence North and West

The selected location is accepted by me and is generally accepted by professional surveyors as the best available evidence of the position of the original corner.

C. Description of monument for corner and accessories established to perpetuate locating the position of the corner:

G-12 Standard Kent County Monument in Stone Pile


- Nail & K.C. remon. tag on W side 7" Elm N 10° E 26.22'
Nail & K.C. remon. tag on S side 6" Ash N 85° W 23.11'
Nail & K.C. remon. tag on S side 10" Ash N 85° E 46.70'
Nail & K.C. remon. tag on N side 40" Maple N 60° E 9.85'

Signed by Randy J. Kolehouse, EARTH TECH

Date 7/23/96

Surveyor's Michigan License No. 25854

STATE OF MICHIGAN COUNTY OF KENT RECEIVED FOR RECORD 96 AUG - 8 AM 8:44 REG. OF DEEDS 9274 Register of Deeds Stamp & File Number

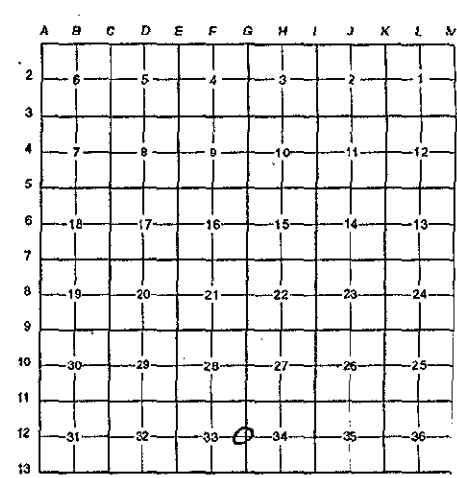

P.A. 345 1990 KENT COUNTY PEER APPROVED 3/27/96 CHAIRMAN [Signature]

