

**SURVEY & REMONUMENTATION**

FEB 14 1997

COMMISSION

**LAND CORNER RECORDATION CERTIFICATE**  
**Filing Requirement of Act 74, Mich. P.A. 1970**  
**KENT COUNTY REMONUMENTATION**

For corners in

Kent (County)	Located in:	Gaines Township	Corner Code #
1. Public Land Survey	T <u>5N</u>	R <u>11W</u>	<u>G-13</u>
	T _____	R _____	_____
	T _____	R _____	_____
	T _____	R _____	_____
2. Property Controlling in Section	S _____	T _____	R _____
	S _____	T _____	R _____
3. Miscellaneous Property in Sec.	S _____	T _____	R _____
	S _____	T _____	R _____

STATE OF MICHIGAN  
 COUNTY OF KENT  
 RECEIVED FOR RECORD  
 96 AUG -8 AM 8:44  
 REG. OF DEEDS  
 9275  
 Register of Deeds Stamp & File Number

4. Lot No. \_\_\_\_\_, Recorded Plat \_\_\_\_\_  
 5. Private Claims \_\_\_\_\_

A	B	C	D	E	F	G	H	I	J	K	L	A
2	6	5	4	3	2	1						
3												
4	7	8	9	10	11	12						
5												
6	16	17	16	15	14	13						
7												
8	19	20	21	22	23	24						
9												
10	30	29	28	27	26	25						
11												
12	31	32	33	34	35	36						
13												

I, Randy Kolehouse, in a field survey on January 17 19 96, do hereby certify that under requirements of P.A. 74 Michigan P.A. of 1970, the corner points mentioned in lines 1 and 2 above were in conformance with regulations and rules therefore as required in the current manual of survey instructions of the United States Department of the interior, Bureau of Land Management or by a decree of a Court of Law and/or that the corner points mentioned in lines 3, 4 and 5 above were in conformance with the rules of the Michigan Board of Land Surveyors or by a Decree of a Court of Law; established, re-established, monumented, re-monumented, recovered, found as expressed below:

**NOTE: Not more than 4 corners, all in the same town and range, may be recorded on this certificate.**

**A. Description of original monument and accessories and/or subsequent restoration:**

G-13	1817	G.L.O. Notes	L. Lyon	Set Post
	N/A	Witness Map	K.C. Surveyor	Iron
	1983	L.C.R.C. #3393	William Byl	Fnd. Iron / Set K.C. Monument
	1989	L.C.R.C. #5061	J. Bueche	K.C. Monument

P.A. 345 1990 KENT COUNTY  
 PEER APPROVED 3/7/96  
 CHAIRMAN Randy Kolehouse

Note: This corner is not common with G-1, T4N, R11W.

This corner was originally approved by the Kent County Remonumentation Peer Group and monumented by William Byl on 4/21/83 and was recorded per L.C.R.C. #3393.

**B. Description of corner evidence found and/or method applied in restoring or reestablishing corner:**

G-13 Found a Standard Kent County Monument on the C/L of 108th Street running E-W 0.5' East of C/L of 6th Street running South as set by William Byl in place of an iron he found which checked K.C. Surveyor's records.

L.C.R.C. #3393

L.C.R.C. #5061

Nail & tag, W sd. 20" Walnut S 50 E 33.05'  
 Nail & tag, N sd. 16" Walnut S 70 E 72.49'  
 Nail & tag, W sd. Power Pole North 61.05'


Nail & Remon Tag W side 24" Walnut S 50° E 33.05' (m. 32.97')  
 Nail & Remon Tag N side 24" Walnut S 80° W 105.56'  
 Nail & Remon Tag S side 20" Walnut stump N 70° W 86.43'  
 Nail & Remon Tag N side 20" Walnut S 70° E 72.49' (m. 72.61')  
 Nail & Remon Tag W side p. pole North 61.05' (m. 61.02')  
 NW corner Section 3, 4-11 West 64.71 (boat spk)  
 C/L gravel road South, West 65' ±

The selected location is accepted by me and is generally accepted by professional surveyors as the best available evidence of the position of the original corner.

**C. Description of monument for corner and accessories established to perpetuate locating the position of the corner:**

G-13 Standard Kent County Monument

Nail & K.C. remon. tag on N side 34" Maple S 85° W 255.89'  
 New Nail & K.C. remon. tag on W side 24" Walnut S 50° E 32.97'  
 New Nail & K.C. remon. tag on N side 24" Walnut (4' High) S 70° E 72.61'  
 Nail & K.C. remon. tag on E side P. pole N 00° W 61.02'  
 NW cor. 3, T4N, R11W, boat spike in monument box West 64.71'

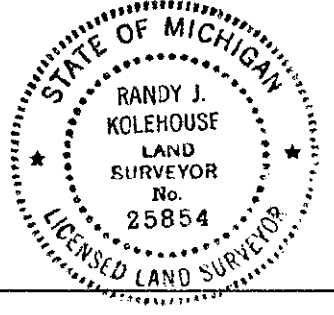

Signed by Randy J. Kolehouse Date 7/23/96  
 EARTH TECH

Surveyor's Michigan License No. 25854