

**SURVEY & REMONUMENTATION**

FEB 14 1997

**LAND CORNER RECORDATION CERTIFICATE**  
**Filing Requirement of Act 74, Mich. P.A. 1970**  
**KENT COUNTY REMONUMENTATION**

For corners in **COMMISSION**

Kent (County)	Located in: Gaines Township	Corner Code #
1. Public Land Survey	T <u>5N</u> R <u>11W</u>	<u>H-1</u>
	T _____ R _____	_____
	T _____ R _____	_____
	T _____ R _____	_____
2. Property Controlling in Section	S _____ T _____ R _____	_____
	S _____ T _____ R _____	_____
3. Miscellaneous Property in Sec.	S _____ T _____ R _____	_____
	S _____ T _____ R _____	_____

STATE OF MICHIGAN  
COUNTY OF KENT  
RECEIVED FOR RECORD

96 AUG -8 AM 8:44

REG. OF DEEDS

9276

Register of Deeds Stamp & File Number

4. Lot No. \_\_\_\_\_, Recorded Plat \_\_\_\_\_  
 5. Private Claims \_\_\_\_\_

	A	B	C	D	E	F	G	H	I	J	K	L
2	6		5		4		3		2		1	
3												
4	7		8		9		10		11		12	
5												
6	18		17		16		15		14		13	
7												
8	19		20		21		22		23		24	
9												
10	30		29		28		27		26		25	
11												
12	31		32		33		34		35		36	
13												

I, Randy Kolehouse, in a field survey on January 2 19 96, do hereby certify that under requirements of P.A. 74 Michigan P.A. of 1970, the corner points mentioned in lines 1 and 2 above were in conformance with regulations and rules therefore as required in the current manual of survey instructions of the United States Department of the Interior, Bureau of Land Management or by a decree of a Court of Law and/or that the corner points mentioned in lines 3, 4 and 5 above were in conformance with the rules of the Michigan Board of Land Surveyors or by a Decree of a Court of Law; established, re-established, monumented, re-monumented, recovered, found as expressed below:

**NOTE: Not more than 4 corners, all in the same town and range, may be recorded on this certificate.**

**A. Description of original monument and accessories and/or subsequent restoration:**

H-1 This corner was not originally set by the G.L.O.

N/A	Witness Map	K.C. Surveyor	Stake & Iron
1983	L.C.R.C. #3324	Williams & Works	3/4" Iron
1983	L.C.R.C. #3473	William Byl	Fnd. 3/4" Iron in Mon. Box / Set K.C. Monument

P.A. 345 1990 KENT COUNTY  
 PEER APPROVED 3/7/96  
 CHAIRMAN Henry Huber

Note: This corner is not common with H-13, T6N, R11W.

This corner was originally approved by the Kent County Remonumentation Peer Group and monumented by William Byl on 7/21/83 and was recorded per L.C.R.C. #3324.

**B. Description of corner evidence found and/or method applied in restoring or reestablishing corner:**

H-1 Found a Standard Kent County Monument 1' North of the C/L of 60th Avenue (bit.) running E & W on the line of a fence running South and 10.55' East of H-13 T6N R11W per L.C.R.C.'s #3324 and #3473 as set by William Byl in place of an iron in a monument box 0.23' South of the Town line which checked K.C. Surveyor's records and L.C.R.C. #3324.


L.C.R.C. #3324	L.C.R.C. #3473
CP-MBT Pole N 20° E 47.95' (m. 47.75')	nail & tag W sd. 24" Basswood N-15-W 48.62'
24" Basswood N 15° W 48.75' (m. 48.65')	nail & tag W sd. CP & MBT Pole N-15-3 47.73'
CP-MBT Pole S 45° W 65.50' (m. 65.61')	nail & tag SE sd. CP & MBT Pole S-45-W 65.58'
1" Iron West 10.55' (m. 10.50')	nail & tag S sd. 277" Oak N-70-W 94.93'
	SW cor. fdn. Hse #2815 N-25-E 122.99'

The selected location is accepted by me and is generally accepted by professional surveyors as the best available evidence of the position of the original corner.

**C. Description of monument for corner and accessories established to perpetuate locating the position of the corner:**

H-1 Standard Kent County Monument on Town Line

Nail & K.C. remon. tag on W side 24" Basswood N 15° W 48.65'  
 Nail & K.C. remon. tag on W side C.P. pole N 15° E 47.75'  
 SW cor. fndn. hse. #2815 N 25° E 122.98'  
 Nail & K.C. remon. tag on SE side CP pole S 45° W 65.61'  
 Nail & K.C. remon. tag on S side 27" Oak N 70° W 94.90'

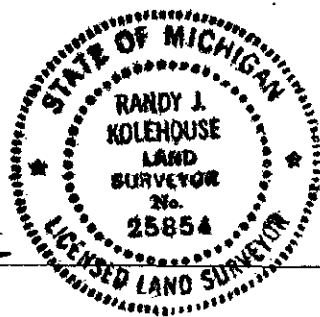

Signed by Randy J. Kolehouse Date 7/23/96  
 EARTH TECH

Surveyor's Michigan License No. 25854