

SURVEY & REMONUMENTATION

APR 27 1995

COMMISSION

**KENT COUNTY REMONUMENTATION
LAND CORNER RECORDATION CERTIFICATE
Filing Requirement of Act 74, Mich. P.A. 1970**

STATE OF MICHIGAN
COUNTY OF KENT
RECEIVED FOR RECORD

94 NOV 23 PM 2:05

Lee J. Bond
REG. OF DEEDS

7267A

Register of Deeds Stamp & File Number

For corners in

GAINES TOWNSHIP

Kent (County)	Located In:	Corner Code -#
1. Public Land Survey	T <u>5N</u> R <u>11W</u>	<u>H-2</u>
	T _____ R _____	<u>Center of</u>
	T _____ R _____	<u>Section 3</u>
	T _____ R _____	
2. Property Controlling in Section	S _____ T _____ R _____	
	S _____ T _____ R _____	<u>Tag. 1</u>
3. Miscellaneous Property in Sec.	S _____ T _____ R _____	
	S _____ T _____ R _____	

4. Lot No. _____, Recorded Plat _____
5. Private Claims _____

I, Chris Marschall, in a field survey on November 16, 19 94, do hereby certify that under requirements of P.A. 74, Michigan P.A. of 1970, the corner points mentioned in lines 1 and 2 above were in conformance with regulations and rules therefore as required in the current manual of survey instructions of the United States Department of the Interior, Bureau of Land Management or by a decree of a Court of Law and/or that the corner points mentioned in lines 3, 4 and 5 above were in conformance with the rules of the Michigan Board of Land Surveyors or by a Decree of a Court of Law; established, re-established, monumented, re-monumented, recovered, found as expressed below:

NOTE: Not more than 4 corners, all in the same town and range, may be recorded on this certificate.

	A	B	C	D	E	F	G	H	I	J	K	L	M
2	6	5	4	3	2	1							
3													
4	7	8	9	10	11	12							
5													
6	18	17	16	15	14	13							
7													
8	19	20	21	22	23	24							
9													
10	30	29	28	27	26	25							
11													
12	31	32	33	34	35	36							
13													

A. Description of original monument and accessories and/or subsequent restoration:

1/2" Iron set by FTCH at intersection of 1/4 lines 1993
 N60°E 4.28' Nail and Shinner SE side 14" Beech
 S85°E 31.57' Nail and Shinner N side 26" Maple
 N 2°E 11.83' Nail and Shinner E side 18" Beech
 This corner not set by GLO. No prior records on this corner.


B. Description of corner evidence found and/or method applied in restoring or reestablishing corner:

Found 1/2" Iron at the intersection of the 1/4 line from above witnesses

P.A. 345 1990 KENT COUNTY
 PEER APPROVED 11/17/94
 CHAIRMAN *Harry Hubel*

C. Description of monument for corner and accessories established to perpetuate locating the position of the corner:

Set Standard Kent County Harrison Monument at intersection of 1/4 lines
 N60°E 4.00' Nail and Remon Tag SE side 14" Beech
 S85°E 31.59' Nail and Remon Tag N side 26" Maple
 N 2°E 11.82' Nail and Remon Tag E side 18" Beech
 N20°W 84.64' Nail and Remon Tag W side 16" Maple
 N60°W 83.82' Nail and Remon Tag S side 10", 8" Cherry Twin
 N75°W 81.44' Nail and Remon Tag N side 10" Oak Twin
 Due W. 6.5' N-S Barb Fence
 Due S. 8.0' E-W WW Fence
 SEE OTHER SIDE FOR 1/4 CORNER TIES

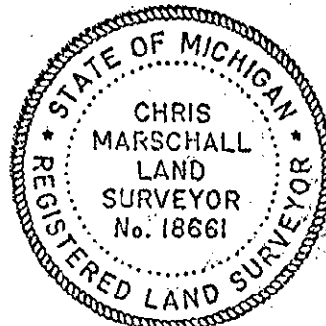

Signed by Chris Marschall Date November 16, 1994
 Surveyor's Michigan License No. 18661