

\$7.00
\$2.00

JAN 23 1996

COMMISSION

LAND CORNER RECORDATION CERTIFICATE
Filing Requirement of Act 74, Mich. P.A. 1970
KENT COUNTY REMONUMENTATION

For corners in

Kent (County)	Located in:	Corner Code #
1. Public Land Survey	T 5N R 11W	H-4
	T _____ R _____	_____
	T _____ R _____	_____
	T _____ R _____	_____
2. Property Controlling in Section	S _____ T _____ R _____	_____
	S _____ T _____ R _____	_____
3. Miscellaneous Property in Sec.	S _____ T _____ R _____	_____
	S _____ T _____ R _____	_____

STATE OF MICHIGAN
COUNTY OF KENT
RECEIVED FOR RECORDS
95 DEC 29 AM 11:41
REG. OF DEEDS
Lucy Stand
8928
Register of Deeds Stamp & File Number

4. Lot No. _____, Recorded Plat _____
5. Private Claims _____

I, Randy Kolehouse, in a field survey on May 15 19 95, do hereby certify that under requirements of P.A. 74 Michigan P.A. of 1970, the corner points mentioned in lines 1 and 2 above were in conformance with regulations and rules therefore as required in the current manual of survey instructions of the United States Department of the Interior, Bureau of Land Management or by a decree of a Court of Law and/or that the corner points mentioned in lines 3, 4 and 5 above were in conformance with the rules of the Michigan Board of Land Surveyors or by a Decree of a Court of Law; established, re-established, monumented, re-monumented, recovered, found as expressed below:

NOTE: Not more than 4 corners, all in the same town and range, may be recorded on this certificate.

A. Description of original monument and accessories and/or subsequent restoration:

H-4 This corner was not originally set by the G.L.O.

1954	Wit. Map	K.C. Surveyor	Iron
1972	L.C.R.C. #361	Exxel Engineering	1/4" Iron

	A	B	C	D	E	F	G	H	I	J	K	L	M
2	6	5	4	3	2	1							
3													
4	7	8	9	10	11	12							
5													
6	18	17	16	15	14	13							
7													
8	19	20	21	22	23	24							
9													
10	30	29	28	27	26	25							
11													
12	31	32	33	34	35	36							
13													

P.A. 345 1990 KENT COUNTY
PEER APPROVED 10/26/99
CHAIRMAN *Harry D. Huber*

B. Description of corner evidence found and/or method applied in restoring or reestablishing corner:

H-4 Found a 1/2" iron per L.C.R.C. #361 in a power line running East & West on line of a tree row running South. This iron has been used since 1950's and is 3.3' South and 1' West of the intersection of 1/4 lines. Accepted iron as Center Section.


L.C.R.C. #361

Nail in side P. Pole N 12.22'
Nail in side P. Pole N 28.03'

C. Description of monument for corner and accessories established to perpetuate locating the position of the corner:

H-4 Replaced 1/2" iron with Standard 4" x 30" Kent County Monument.

Nail & bottle cap in E side P. pole due North 12.22'
Nail & bottle cap in E side P. pole due N 28.03'
Nail & K.C. remon. tag in E side 10" Tree S 5° E 63.27'
Nail & K.C. remon. tag in W side 14" Ash due South 126.02'

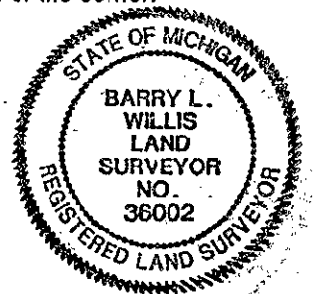

Signed by *Barry Willis* Date *Dec. 22, 1995*
EARTH TECH

Surveyor's Michigan License No. 25854