

KENT COUNTY REMONUMENTATION

LAND CORNER RECORDATION CERTIFICATE  
Filing Requirement of Act 74, Mich. P.A. 1970

\$7.00  
\$2.00

SEP 18 1995

COMMISSION

For corners in  
KENT COUNTY  
(County)

Located In:

Corner Code #

- |                                      |   |    |   |     |     |
|--------------------------------------|---|----|---|-----|-----|
| 1. Public Land Survey                | T | 5N | R | 11W | H-6 |
|                                      | T |    | R |     |     |
|                                      | T |    | R |     |     |
|                                      | T |    | R |     |     |
| 2. Property Controlling in Section   | S |    | T | R   |     |
|                                      | S |    | T | R   |     |
| 3. Miscellaneous Property in Section | S |    | T | R   |     |
|                                      | S |    | T | R   |     |

STATE OF MICHIGAN  
COUNTY OF KENT  
RECEIVED FOR RECORD  
95 JUL 11 PM 1:53  
REG. OF DEEDS  
*W. J. Stand*

8527

Register of Deeds Stamp & File Number

4. Lot No. \_\_\_\_\_, Recorded Plat \_\_\_\_\_  
5. Private Claims \_\_\_\_\_

A	B	C	D	E	F	G	H	I	J	K	L	M
2	6		5	4		3		2		1		
3												
4	7		8	9		10		11		12		
5												
6	18		17	16		15		14		13		
7												
8	19		20	21		22		23		24		
9												
10	30		29	28		27		26		25		
11												
12	31		32	33		34		35		36		
13												

I, Kirk Breitels, in a field survey on June 30, 1995, do hereby certify that under requirements of P.A. 74, Michigan P.A. of 1970, the corner points mentioned in lines 1 and 2 above were in conformance with regulations and rules therefore as required in the current manual of survey instructions of the United States Department of the Interior, Bureau of Land Management or by a decree of a Court of Law and/or that the corner points mentioned in lines 3, 4 and 5 above were in conformance with the rules of the Michigan Board of Professional Surveyors or by a Decree of a Court of Law; established, re-established, monumented, re-monumented, recovered, found as expressed below:

NOTE: Not more than 4 corners, all in the same town and range, may be recorded on this certificate.

A. Description of original monument and accessories and/or subsequent restoration:

H-6 1830 GLO Not Set  
1978 LCRC #1163 Bonnema Set capped rered at "X" 1/4 lines

B. Description of corner evidence found and/or method applied in restoring or reestablishing corner:

H-6 Found Capped Rerod (Exxel) per LCRC #1163. Capped Rerod is less than 0.1' from the true "X" 1/4 lines. Said Capped Rerod has been used in many surveys by various surveyors over the years.

LCRC #1163

Spike in 4" Elm N 4.78'  
Spike in 16" Beech SSE 26.95'  
Spike in 6" Apple WSW 5.46'  
E. end of E-W fence E 1.3' m/l

P.A. 345 1990 KENT COUNTY

PEER APPROVED 6/22/95


CHAIRMAN

*Harry Hubert*

The Capped Rerod is accepted by me and is generally accepted by professional surveyors as the best available evidence of the position of the corner.

C. Description of monument for corner and accessories established to perpetuate locating the position of the corner:

H-6 Set Standard Kent County Monument in place of Capped Rerod  
Set Nail & KC Remon. tag W. side 24" Beech S25°E 27.04'  
Set Nail & KC Remon. tag N. side 12" Oak N60°W 14.03'  
Set Nail & KC Remon. tag S. side 10" Apple S60°W 5.57'  
Set Nail & KC Remon. tag N. side 4" Elm S75°E 20.27'  
Set Nail & KC Remon. tag E. side 6" Beech S30°W 33.77'  
At E. end of fence to west m/l

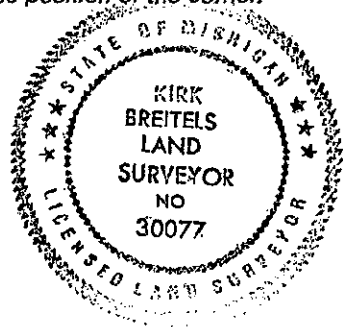

Signed by *Kirk Breitels*  
Surveyor's Michigan License No. 30077

Date 7/6/95