

SURVEY & REMONUMENTATION

FEB 14 1997

COMMISSION

LAND CORNER RECORDATION CERTIFICATE
Filing Requirement of Act 74, Mich. P.A. 1970
KENT COUNTY REMONUMENTATION


For corners in

| <u>Kent</u> (County) | Located in: | Gaines Township | Corner Code # |
|------------------------------------|-------------|--------------------|---------------|
| 1. Public Land Survey | T <u>5N</u> | R <u>11W</u> | <u>H-11</u> |
| | T _____ | R _____ | _____ |
| | T _____ | R _____ | _____ |
| | T _____ | R _____ | _____ |
| 2. Property Controlling in Section | S _____ | T _____ | R _____ |
| | S _____ | T _____ | R _____ |
| 3. Miscellaneous | S _____ | T _____ | R _____ |
| Property in Sec. | S _____ | T _____ | R _____ |

STATE OF MICHIGAN
 COUNTY OF KENT
 RECEIVED FOR RECORD
 96 AUG -8 AM 8:45
 REG. OF DEEDS
W. J. Koles
 9282
 Register of Deeds Stamp & File Number

4. Lot No. _____, Recorded Plat _____
 5. Private Claims _____

I, Randy Kolehouse, in a field survey on January 2 19 96, do hereby certify that under requirements of P.A. 74 Michigan P.A. of 1970, the corner points mentioned in lines 1 and 2 above were in conformance with regulations and rules therefore as required in the current manual of survey instructions of the United States Department of the interior, Bureau of Land Management or by a decree of a Court of Law and/or that the corner points mentioned in lines 3, 4 and 5 above were in conformance with the rules of the Michigan Board of Land Surveyors or by a Decree of a Court of Law; established, re-established, monumented, re-monumented, recovered, found as expressed below:

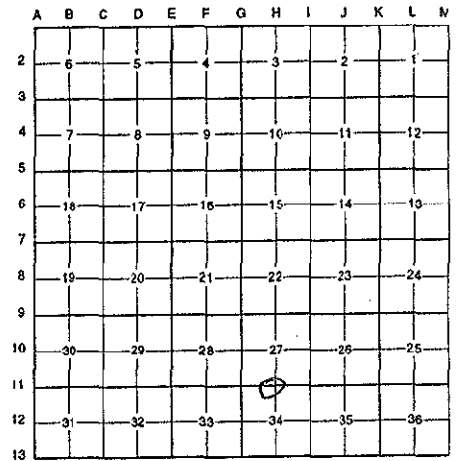

NOTE: Not more than 4 corners, all in the same town and range, may be recorded on this certificate.

A. Description of original monument and accessories and/or subsequent restoration:

| H-11 | 1831 | G.L.O. Notes | Mullett | Set Post |
|------|------|----------------|---------------------|--|
| | 1953 | Witness Map | K.C. Surveyor | 3/4" Iron in Mon. Box |
| | 1974 | L.C.R.C. #642 | Exxel Engineering | 1/2" Iron in Mon. Box |
| | 1982 | L.C.R.C. #2829 | Jonker Land Surveys | Fnd. 1/2" Iron in Mon. Box / Set K.C. Monument |
| | 1989 | L.C.R.C. #5066 | J. Bueche | K.C. Monument |
| | 1994 | L.C.R.C. #7180 | Glaza Associates | K.C. Monument |

P.A. 345 1990 KENT COUNTY
 PEER APPROVED 3/7/96
 CHAIRMAN *Henry*

This corner was originally approved by the Kent County Remonumentation Peer Group and monumented by Rob Jonker on 4/20/82 and was recorded per L.C.R.C. #2829.

B. Description of corner evidence found and/or method applied in restoring or reestablishing corner:


H-11 Found a Standard Kent County Monument in the C/L of 100th Street (bit.) running East & West on line of tree row running North & South per L.C.R.C.'s #2829, #5066 and #7180 as set by Rob Jonker in place of a 1/2" iron in a monument box he found that checked L.C.R.C. #642 and K.C. Surveyor's records.

| L.C.R.C. #2829 | L.C.R.C. #5066 | L.C.R.C. #7180 |
|---|--|--|
| Remon. tag on E side 26" Ash N 03° E 75.87' | Nail & Remon Tag E side 30" Ash (7' high) N 03° E 75.87' | Nail & K.C. remon tag in E side 30" Ash N 03° E 75.91' |
| Remon. tag on NW side p. pole N 70° E 110.59' | New Nail & Remon Tag NW side p. pole N 70° E 110.59' | Nail & K.C. remon tag in NW side P. pole N 70° E 110.59' |
| NE cor. garage fnd. S 10° W 93.03' | Nail & Remon Tag N side 14" Elm S 50° W 53.20' | NE corner of garage foundation S 10° W 93.03' |
| NW cor. house fnd. S 45° W 120.08' | NE cor garage fnd S 10° W 93.03' | NE corner of house foundation S 45° W 120.08' |
| | NE cor house fnd S 45° W 120.08' | On line with North-South tree lines |

The selected location is accepted by me and is generally accepted by professional surveyors as the best available evidence of the position of the original corner.

C. Description of monument for corner and accessories established to perpetuate locating the position of the corner:

H-11 Standard Kent County Monument
 Nail & K.C. remon. tag on E side 30" Ash N 03° E 75.91'
 Nail & K.C. remon. tag on NW side P. pole N 70° E 110.59'
 NE cor. garage fndn. S 10° W 93.03'
 NW cor. hse. fndn. S 45° W 120.08'

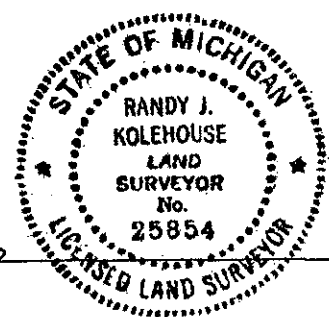

Signed by Randy J. Kolehouse Date 7/23/96
 EARTH TECH
 Surveyor's Michigan License No. 25854