

SURVEY & REMONUMENTATION

FEB 14 1997

COMMISSION

LAND CORNER RECORDATION CERTIFICATE
Filing Requirement of Act 74, Mich. P.A. 1970
KENT COUNTY REMONUMENTATION

For corners in

| Kent (County) | Located in: Gains Township | Corner Code # |
|---------------------------------------|-------------------------------|---------------|
| 1. Public Land Survey | T <u>5N</u> R <u>11W</u> | <u>I-1</u> |
| | T _____ R _____ | _____ |
| | T _____ R _____ | _____ |
| | T _____ R _____ | _____ |
| 2. Property Controlling in Section | S _____ T _____ R _____ | _____ |
| | S _____ T _____ R _____ | _____ |
| 3. Miscellaneous Property in Sec. | S _____ T _____ R _____ | _____ |
| | S _____ T _____ R _____ | _____ |

STATE OF MICHIGAN
 COUNTY OF KENT
 RECEIVED FOR RECORD
 96 AUG -8 AM 8:45
 REG. OF DEEDS
Lucy Standa
9285
 Register of Deeds Stamp & File Number

4. Lot No. _____, Recorded Plat _____
 5. Private Claims _____

I, Randy Kolehouse, in a field survey on January 29 19 96, do hereby certify that under requirements of P.A. 74 Michigan P.A. of 1970, the corner points mentioned in lines 1 and 2 above were in conformance with regulations and rules therefore as required in the current manual of survey instructions of the United States Department of the interior, Bureau of Land Management or by a decree of a Court of Law and/or that the corner points mentioned in lines 3, 4 and 5 above were in conformance with the rules of the Michigan Board of Land Surveyors or by a Decree of a Court of Law; established, re-established, monumented, re-monumented, recovered, found as expressed below:

| | | | | | | | | | | | | |
|----|----|----|----|----|----|----|---|---|---|---|---|---|
| A | B | C | D | E | F | G | H | I | J | K | L | M |
| 2 | 6 | 5 | 4 | 3 | 2 | 1 | | | | | | |
| 3 | | | | | | | | | | | | |
| 4 | 7 | 8 | 9 | 10 | 11 | 12 | | | | | | |
| 5 | | | | | | | | | | | | |
| 6 | 18 | 17 | 16 | 15 | 14 | 13 | | | | | | |
| 7 | | | | | | | | | | | | |
| 8 | 19 | 20 | 21 | 22 | 23 | 24 | | | | | | |
| 9 | | | | | | | | | | | | |
| 10 | 30 | 29 | 28 | 27 | 26 | 25 | | | | | | |
| 11 | | | | | | | | | | | | |
| 12 | 31 | 32 | 33 | 34 | 35 | 36 | | | | | | |
| 13 | | | | | | | | | | | | |

NOTE: Not more than 4 corners, all in the same town and range, may be recorded on this certificate.

A. Description of original monument and accessories and/or subsequent restoration:

| | | | | |
|-----|------|----------------|-------------------|--|
| I-1 | 1831 | G.L.O. Notes | Mullett | Set Post |
| | 1963 | Witness Map | K.C. Surveyor | Concrete Monument |
| | 1977 | L.C.R.C. #1042 | Exxel Engineering | 3/4" Iron in Mon. Box |
| | 1974 | L.C.R.C. #3324 | Williams & Works | 1 1/2" Iron in Mon. Box |
| | 1983 | L.C.R.C. #3474 | William Byl | Fnd. 1-1/2" Iron in Mon. Box / Set K.C. Monument in Mon. Box |
| | 1988 | L.C.R.C. #5001 | J. Bueche | K.C. Monument in Mon. Box |

P.A. 345 1990 KENT COUNTY
 PEER APPROVED 3/7/96
 CHAIRMAN Hampshire

Note: This corner is not common with I-13, T6N, R11W.

This corner was originally approved by the Kent County Remonumentation Peer Group and monumented by William Byl on 7/25/83 and was recorded per L.C.R.C. #3474.

B. Description of corner evidence found and/or method applied in restoring or reestablishing corner:

I-1 Monument and monument box had been removed. Established location by holding from witnesses in L.C.R.C.'s #3474 and #5001. Set Standard Kent County Monument at center of Witness intersections.


| L.C.R.C. #3474 | L.C.R.C. #5001 |
|--|---|
| nail & tag N sd. P. Pole S-80-E 114.38' | Nail & Remon Tag N side p. pole S 80° E 114.38' (m. 114.31') |
| nail & tag NW sd. 18" Pine S-50-W 85.35' | Nail & Remon Tag NW side 22" Pine S 50° W 85.35' (m. 85.24') |
| | Nail & Remon Tag in W side p. pole S 30° E 49.75' (m. 49.75') |
| | C/L blacktop E&W is South 4' ±, blacktop South is West 6' ± |

The selected location is accepted by me and is generally accepted by professional surveyors as the best available evidence of the position of the original corner.

C. Description of monument for corner and accessories established to perpetuate locating the position of the corner:

I-1 Standard Kent County Monument on Township Line

Nail & K.C. remon. tag on NW side 8" Ash N 55° E 56.31'
 Nail & K.C. remon. tag on N side P. pole S 80° E 114.31'
 Nail & K.C. remon. tag on W side P. pole S 30° E 49.75'
 Nail & K.C. remon. tag on NW side 22" Pine S 50° W 85.24'

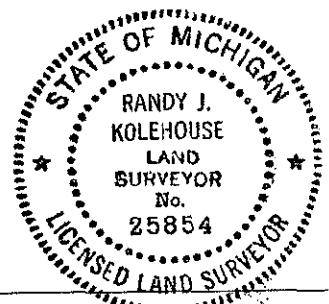

Signed by Randy J. Kolehouse Date 7/23/96
 EARTH TECH

Surveyor's Michigan License No. 25854