

SURVEY & REMONUMENTATION

FEB 14 1997

COMMISSION

LAND CORNER RECORDATION CERTIFICATE
Filing Requirement of Act 74, Mich. P.A. 1970
KENT COUNTY REMONUMENTATION

For corners in

Kent (County)	Located in: Gaines Township	Corner Code #
1. Public Land Survey	T <u>5N</u> R <u>11W</u>	<u>1-2</u>
	T _____ R _____	_____
	T _____ R _____	_____
	T _____ R _____	_____
2. Property Controlling in Section	S _____ T _____ R _____	_____
	S _____ T _____ R _____	_____
3. Miscellaneous Property in Sec.	S _____ T _____ R _____	_____
	S _____ T _____ R _____	_____

STATE OF MICHIGAN
 COUNTY OF KENT
 RECEIVED FOR RECORD

96 AUG -8 AM 8:45

REG. OF DEEDS
Luis S. Sand
 9286

Register of Deeds Stamp & File Number


4. Lot No. _____, Recorded Plat _____
 5. Private Claims _____

I, Randy Kolehouse, in a field survey on January 2 19 96, do hereby certify that under requirements of P.A. 74 Michigan P.A. of 1970, the corner points mentioned in lines 1 and 2 above were in conformance with regulations and rules therefore as required in the current manual of survey instructions of the United States Department of the interior, Bureau of Land Management or by a decree of a Court of Law and/or that the corner points mentioned in lines 3, 4 and 5 above were in conformance with the rules of the Michigan Board of Land Surveyors or by a Decree of a Court of Law; established, re-established, monumented, re-monumented, recovered, found as expressed below:

NOTE: Not more than 4 corners, all in the same town and range, may be recorded on this certificate.

A. Description of original monument and accessories and/or subsequent restoration:

Date	Description	Surveyor	Monument
1-2 1831	G.L.O. Notes	Mullett	Set Post
1963	Witness Map	K.C. Surveyor	1" Iron
1974	L.C.R.C. #3324	Williams & Works	1" Iron
1983	L.C.R.C. #3584	J. Bueche	Fnd. 1" Iron / Set K.C. Monument
1994	L.C.R.C. #7177	Glaza Associates	K.C. Monument

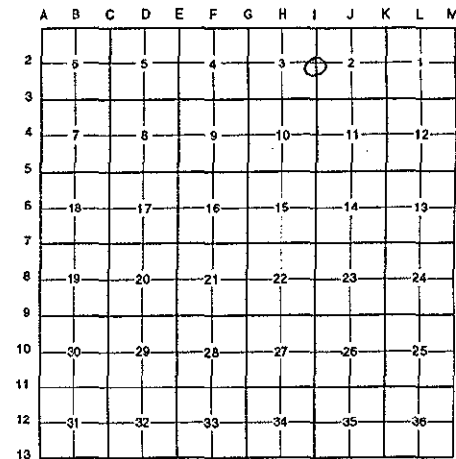

P.A. 345 1990 KENT COUNTY
 PEER APPROVED 3/7/96
 CHAIRMAN Ferry

This corner was originally approved by the Kent County Remonumentation Peer Group and monumented by J. Bueche on 10/10/83 and was recorded per L.C.R.C. #3584.

B. Description of corner evidence found and/or method applied in restoring or reestablishing corner:

1-2 Found a Standard Kent County Monument 24' M/L East of the C/L of Hanna Lake Road (bit.) running North, West, and South per L.C.R.C.'s #3324, #3584 and #7177 as set by J. Bueche in place of a 1" x 18" iron over the top of a 1" x 24" iron (24" below ground surface) he found that checked L.C.R.C. #3324 and K.C. Surveyor's records.

L.C.R.C. #3584

K.C. Remon. tag & nail in N. side Tel. pole S 60° W 105.79'
 K.C. Remon. tag & nail in E. side 16" Maple S 20° W 143.76'
 Face of steel fence post S 90° E 33.05'; on fence East
 C/L blacktop N & S is West 24' ±

L.C.R.C. #7177

K.C. remon tag & nail in N side T. pole S 60° W 105.79' (m. 105.82')
 K.C. remon tag & nail in E side 20" Maple S 20° W 143.73' (m. 143.66')
 Face of steel fence post S 90° E 33.05'
 K.C. remon tag & nail in E side P. pole (5' above grade) S 20° E 97.20' (m. 97.13')
 K.C. remon tag & nail in W side P. pole N 03° E 147.15' (m. 147.05')

The selected location is accepted by me and is generally accepted by professional surveyors as the best available evidence of the position of the original corner.

C. Description of monument for corner and accessories established to perpetuate locating the position of the corner:

1-2 Standard Kent County Monument

- Nail & K.C. remon. tag on N side T. pole S 60° W 105.82'
- Nail & K.C. remon. tag on E side 20" Maple S 20° W 143.66'
- Face steel fence post N 90° E 33.05'
- Nail & K.C. remon. tag on E side P. pole (5' above ground) S 20° E 97.13'
- Nail & K.C. remon. tag on NW side P. pole N 03° E 147.05'

Signed by Randy J. Kolehouse Date 7/23/96
 EARTH TECH

Surveyor's Michigan License No. 25854

