

SURVEY & REMONUMENTATION

SEP 03 1999

LAND CORNER RECORDATION CERTIFICATE Filing Requirement of Act 74, Mich. P.A. 1970 KENT COUNTY REMONUMENTATION

For corners in

SECTION

Kent <small>(County)</small>		Located in: <u>Gaines</u> <small>Township</small>	Corner Code # <u>I-3</u>
1. Public Land Survey	T <u>5N</u> R <u>11W</u>		
	T _____ R _____		
	T _____ R _____		
	T _____ R _____		
2. Property Controlling in Section	S _____ T _____ R _____		
	S _____ T _____ R _____		
3. Miscellaneous Property in Sec.	S _____ T _____ R _____		
	S _____ T _____ R _____		

STATE OF MICHIGAN
COUNTY CLERK
RECEIVED FOR RECORD


95 AUG -8 AM 8:45

REG. OF DEEDS
9287

Register of Deeds Stamp & File Number

4. Lot No. _____, Recorded Plat _____
5. Private Claims _____

I, Randy Kolehouse, in a field survey on December 28 19 95, do hereby certify that under requirements of P.A. 74 Michigan P.A. of 1970, the corner points mentioned in lines 1 and 2 above were in conformance with regulations and rules therefore as required in the current manual of survey instructions of the United States Department of the interior, Bureau of Land Management or by a decree of a Court of Law and/or that the corner points mentioned in lines 3, 4 and 5 above were in conformance with the rules of the Michigan Board of Land Surveyors or by a Decree of a Court of Law; established, re-established, monumented, re-monumented, recovered, found as expressed below:

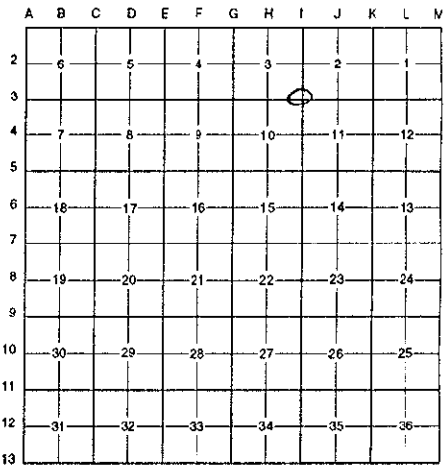

NOTE: Not more than 4 corners, all in the same town and range, may be recorded on this certificate.

A. Description of original monument and accessories and/or subsequent restoration:

I-3	1831	G.L.O. Notes	Mullett	Set Post
	N/A	Witness Map	K.C. Surveyor	Monument Box
	1976	L.C.R.C. #909	Exxel Engineering	Iron in Mon. Box
	1982	L.C.R.C. #2830	Jonker Land Surveys	Fnd. Iron in Mon. Box / Set K.C. Monument
	1994	L.C.R.C. #7202	Glaza & Associates	K.C. Monument

P.A. 345 1990 KENT COUNTY
PEER APPROVED 3/7/96
CHAIRMAN Harry Huber

This corner was originally approved by the Kent County Remonumentation Peer Group and monumented by 4/1/82 on Jonker Land Surveys and was recorded per L.C.R.C. #2830.


B. Description of corner evidence found and/or method applied in restoring or reestablishing corner:

I-3 Found a Standard Kent County Monument in a monument box on the C/L of 68th Street running E & W and C/L of Hanna Lake Avenue running N-S as set by Rob Jonker in place of iron they found in a monument box which checked L.C.R.C. #909 and K.C. Surveyor's records.	
L.C.R.C. #2830	L.C.R.C. #7202
NW corner gas station S 55° E 78.12'	NW corner of gas station S 55° E 78.12' (m. 78.10')
NE corner fnd. to bell tower N 38° W 101.3'	NE corner foundation to bell tower N 38° W 101.30'
SE corner gas station S 20° W 110.66'	SE corner of gas station S 20° W 110.66'
NW corner gas station S 45° W 92.6'	NW corner of gas station S 45° W 92.6' (m. 92.60')
C/L MH N 90° E 27.47'	
C/L MH S 55° W 33.11'	

The selected location is accepted by me and is generally accepted by professional surveyors as the best available evidence of the position of the original corner.

C. Description of monument for corner and accessories established to perpetuate locating the position of the corner:

I-3 Standard Kent County Monument in a Monument Box	
Foundation NW corner of gas station S 55° E 78.10'	
Foundation NE corner to bell tower N 38° W 101.30'	
SE corner of gas station S 20° W 110.66'	
NW corner of gas station S 45° W 92.60'	

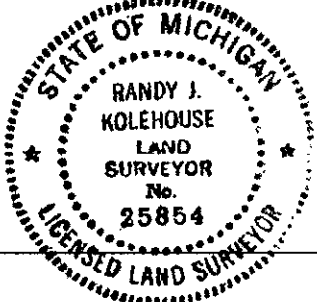

Signed by Randy J. Kolehouse
EARTH TECH
Surveyor's Michigan License No. 25854

Date 7/23/98