

REMONUMENTATION

SEP 03 1999

SECTION

LAND CORNER RECORDATION CERTIFICATE
Filing Requirement of Act 74, Mich. P.A. 1970
KENT COUNTY REMONUMENTATION


For corners in

Table with columns: Kent (County), Located in: (Gaines Township), Corner Code #. Rows include Public Land Survey, Property Controlling in Section, and Miscellaneous Property in Sec.

Register of Deeds Stamp & File Number. Includes handwritten signature, date 96 AUG -8 AM 8:45, and file number 9288.

4. Lot No. _____, Recorded Plat _____
5. Private Claims _____

I, Randy Kolehouse, in a field survey on December 27, 1995, do hereby certify that under requirements of P.A. 74 Michigan P.A. of 1970, the corner points mentioned in lines 1 and 2 above were in conformance with regulations and rules therefore as required in the current manual of survey instructions of the United States Department of the interior, Bureau of Land Management or by a decree of a Court of Law and/or that the corner points mentioned in lines 3, 4 and 5 above were in conformance with the rules of the Michigan Board of Land Surveyors or by a Decree of a Court of Law; established, re-established, monumented, re-monumented, recovered, found as expressed below:

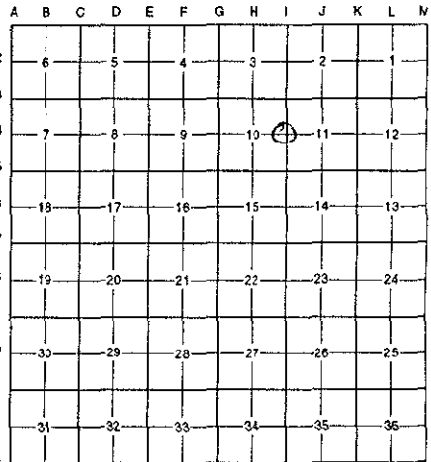

NOTE: Not more than 4 corners, all in the same town and range, may be recorded on this certificate.

A. Description of original monument and accessories and/or subsequent restoration:

Table listing descriptions of original monuments and accessories, including G.L.O. Notes, Witness Map, L.C.R.C. numbers, and various types of monuments (Set Post, Iron in Mon. Box, etc.).

P.A. 345 1990 KENT COUNTY PEER APPROVED 3/27/96 CHAIRMAN [Signature]

This corner was originally approved by the Kent County Remonumentation Peer Group and monumented by Rob Jonker on 4/14/82 and was recorded per L.C.R.C. #2831.

B. Description of corner evidence found and/or method applied in restoring or reestablishing corner:

1-4 Found a Standard Kent County Monument 0.5' East of Hanna Lake Road running N-S per L.C.R.C.'s #2831 and #7183 as set by Jonker Land Surveys in place of an iron they found in a monument box which checked L.C.R.C. #909 and K.C. Surveyor's records.

L.C.R.C. #2831

L.C.R.C. #7183

- 'X' on top culvert 1' W of East end N 50° E 36.55'
'X' on top culvert 1' E of West end N 45° W 35.22'
'X' on top culvert 1' West of East end N 50° E 36.55'
'X' on top culvert 1' East of West end N 45° W 35.22'
On C/L North-South pavement
K.C. remon tag & nail in West side P. pole N 15° E 69.51'
K.C. remon tag & nail in North side P. pole S 70° W 28.64' (m. 28.55')

The selected location is accepted by me and is generally accepted by professional surveyors as the best available evidence of the position of the original corner.

C. Description of monument for corner and accessories established to perpetuate locating the position of the corner:

- 1-4 Standard Kent County Monument
'X' on top culvert 1.0' West of East end N 50° E 36.55'
'X' on top culvert 1.0' East of West end N 45° W 35.22'
Nail & K.C. remon. tag on W side P. pole N 15° E 69.51'
Nail & K.C. remon. tag on N side P. pole S 70° W 28.55'

Signed by Randy J. Kolehouse

Date 7/23/96

Surveyor's Michigan License No. 25854

