

SURVEY & REMONUMENTATION

SEP 03 1999

SECTION

LAND CORNER RECORDATION CERTIFICATE Filing Requirement of Act 74, Mich. P.A. 1970 KENT COUNTY REMONUMENTATION

For corners in

Kent (County)	Located in: Gaines Township	Corner Code #	
1. Public Land Survey	T <u>5N</u> R <u>11W</u>	<u>1-5</u>	
	T _____ R _____	_____	
	T _____ R _____	_____	
	T _____ R _____	_____	
2. Property Controlling in Section	S _____ T _____ R _____	_____	
	S _____ T _____ R _____	_____	
3. Miscellaneous Property in Sec.	S _____ T _____ R _____	_____	
	S _____ T _____ R _____	_____	

STATE OF MICHIGAN
 COUNTY OF KENT
 REGISTERED FOR RECORD
 96 AUG - 8 AM @ 45
 REG. OF DEEDS
[Signature]


9289

Register of Deeds Stamp & File Number

4. Lot No. _____, Recorded Plat _____
5. Private Claims _____

I, Randy Kolehouse, in a field survey on December 27 19 95, do hereby certify that under requirements of P.A. 74 Michigan P.A. of 1970, the corner points mentioned in lines 1 and 2 above were in conformance with regulations and rules therefore as required in the current manual of survey instructions of the United States Department of the interior, Bureau of Land Management or by a decree of a Court of Law and/or that the corner points mentioned in lines 3, 4 and 5 above were in conformance with the rules of the Michigan Board of Land Surveyors or by a Decree of a Court of Law; established, re-established, monumented, re-monumented, recovered, found as expressed below:

NOTE: Not more than 4 corners, all in the same town and range, may be recorded on this certificate.

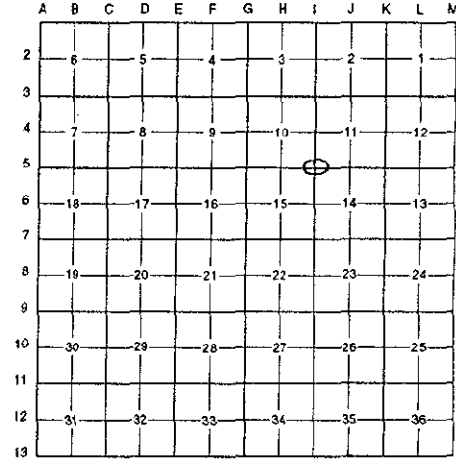

A. Description of original monument and accessories and/or subsequent restoration:

I-5	1831 G.L.O. Notes	Mullett	Set Post
	1965 Witness Map	K.C. Surveyor	Square Iron w/"X" in Concrete
	1974 L.C.R.C. #721	Nederveld & Jonker	1/2" Iron in Monument Box
	1982 L.C.R.C. #2990	William Byl	Fnd. 3/4" Iron in Mon. Box / Set K.C. Monument
	1994 L.C.R.C. #7201	Glaza & Associates	K.C. Monument

P.A. 345 1990 KENT COUNTY
 PEER APPROVED 3/7/96
 CHAIRMAN [Signature]

This corner was originally approved by the Kent County Remonumentation Peer Group and monumented by William Byl on 5/2/482 and was recorded per L.C.R.C. #2990.

B. Description of corner evidence found and/or method applied in restoring or reestablishing corner:


I-5 Found a Standard Kent County Monument 0.5' East of C/L (bit.) of Hanna Lake Road and 0.5' North of C/L (bit.) of 76th Street per L.C.R.C.'s #2990 and #7201 as set by William Byl in place of a 1/2" iron they found in monument box which checked L.C.R.C. #721 and K.C. Surveyor's records.

L.C.R.C. #2990	L.C.R.C. #7201
Nail & tag, E sd. P. Pole N 30° W 83.31' (m. 82.28')	Nail & K.C. remon. tag in E side P. pole N 30° W 82.28'
Nail & tag, N sd. P. Pole S 80° W 130.11'	Nail & K.C. remon. tag in N side P. pole S 80° W 130.11'
NE cor. brick house S 55° W 167.95'	Nail & K.C. remon. tag in SE side P. pole S 65° W 52.42'
	Nail & K.C. remon. tag in S side 48" Oak N 75° E 104.61' (m. 104.56')

The selected location is accepted by me and is generally accepted by professional surveyors as the best available evidence of the position of the original corner.

C. Description of monument for corner and accessories established to perpetuate locating the position of the corner:

- I-5 Standard Kent County Monument
- Nail & K.C. remon. tag in E side P. pole N 30° W 82.28'
 - Nail & K.C. remon. tag in N side P. pole S 80° W 130.11'
 - Nail & K.C. remon. tag in SE side P. pole S 65° W 52.42'
 - Nail & K.C. remon. tag in S side 48" Oak N 75° E 104.56'

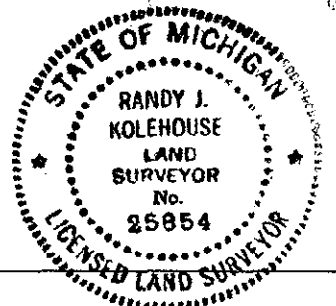

Signed by *Randy J. Kolehouse* Date 7/23/96
 EARTH TECH

Surveyor's Michigan License No. 25854