

SEP 03 1999

SECTION

LAND CORNER RECORDATION CERTIFICATE
Filing Requirement of Act 74, Mich. P.A. 1970
KENT COUNTY REMONUMENTATION

For corners in

Kent (County)	Located in: Gains Township	Corner Code #
1. Public Land Survey	T <u>5N</u> R <u>11W</u>	<u>I-6</u>
	T _____ R _____	_____
	T _____ R _____	_____
	T _____ R _____	_____
2. Property Controlling in Section	S _____ T _____ R _____	_____
	S _____ T _____ R _____	_____
3. Miscellaneous Property in Sec.	S _____ T _____ R _____	_____
	S _____ T _____ R _____	_____

STATE OF MICHIGAN
COUNTY OF KENT
REGISTER OF DEEDS

96 AUG -8 AM 8:45


REG. OF DEEDS
9290

Register of Deeds Stamp & File Number

4. Lot No. _____, Recorded Plat _____
5. Private Claims _____

I, Randy Kolehouse, in a field survey on January 26 19 96, do hereby certify that under requirements of P.A. 74 Michigan P.A. of 1970, the corner points mentioned in lines 1 and 2 above were in conformance with regulations and rules therefore as required in the current manual of survey instructions of the United States Department of the interior, Bureau of Land Management or by a decree of a Court of Law and/or that the corner points mentioned in lines 3, 4 and 5 above were in conformance with the rules of the Michigan Board of Land Surveyors or by a Decree of a Court of Law; established, re-established, monumented, re-monumented, recovered, found as expressed below:

NOTE: Not more than 4 corners, all in the same town and range, may be recorded on this certificate.

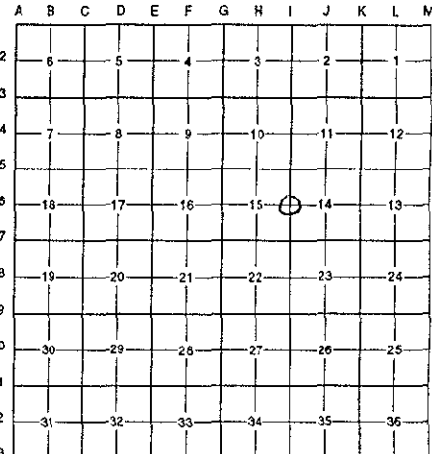

A. Description of original monument and accessories and/or subsequent restoration:

I-6	1831	G.L.O. Notes	Mullett	Set Post
	N/A	Witness Map	K.C. Surveyor	"X" in Concete
	1975	L.C.R.C. #808	Exxel Engineering	1" Iron in Monument Box
	1980	L.C.R.C. #1798	WilliamByl	Fnd. 1" Iron in Mon. Box Over "X" in Conc.
	1994	L.C.R.C. #7184	Glaza & Associates	K.C. Monument

P.A. 345 1990 KENT COUNTY
PEER APPROVED 3/7/96
CHAIRMAN Randy Kolehouse
Conc. / Set K.C. Monument in Mon. Box

This corner was originally approved by the Kent County Remonumentation Peer Group and monumented by WilliamByl on 12/17/80 and was recorded per L.C.R.C. #1798.

B. Description of corner evidence found and/or method applied in restoring or reestablishing corner:

I-6 Found a Standard Kent County Monument in a monument box on the C/Lof Hanna Lake Road (bit.) running N-S on line of a fence running E-W per L.C.R.C.'s #1798 and #7184 as set by WilliamByl in place of a 1" iron he found in a monument box which checked L.C.R.C. #808 and K.C. Surveyor's records.

L.C.R.C. #1798

L.C.R.C. #7184

Nail & tag, E side 16" Aspen NE 49.05'
Nail & tag, N side 6" Quadruple Ash SE 61.03'
Nail & tag, N side 12" Ash W 70.65'
Nail & tag, N side 8" Elm WNW 30.66'

Nail & K.C. remon. tag on E side 18" Aspen N 45° E 49.05'
Nail & K.C. remon. tag on N side 14" Quadruple Ash S 60° E 61.07' (m. 60.98')
Nail & K.C. remon. tag on N side 14" Ash N 80° W 70.69' (m. 70.60')
Nail & K.C. remon tag in N (South) side 12" Elm N 75° W 30.59' (m. 30.51')
In C/L bit. road

The selected location is accepted by me and is generally accepted by professional surveyors as the best available evidence of the position of the original corner.

C. Description of monument for corner and accessories established to perpetuate locating the position of the corner:

I-6 Standard Kent County Monument in a Monument Box

New Nail & K.C. remon. tag on SW side 12" Elm N 35° W 58.32'
Nail & K.C. remon. tag on E side 18" Aspen N 45° E 49.05'
Nail & K.C. remon. tag on N side 14" Quad. Ash S 60° E 60.98'
Nail & K.C. remon. tag on N side 14" Ash N 80° W 70.60'
Nail & K.C. remon. tag on S side 12" Elm N 75° W 30.51'

Signed by Randy J. Kolehouse
EARTH TECH

Date 7/23/96

Surveyor's Michigan License No. 25854

