

# SURVEY & REMONUMENTATION

SEP 03 1999

## LAND CORNER RECORDATION CERTIFICATE Filing Requirement of Act 74, Mich. P.A. 1970 KENT COUNTY REMONUMENTATION

For corners in SECTION  
Kent  
(County)

Located in: Gaines Township      Corner Code # \_\_\_\_\_

|                                    |             |              |         |       |       |
|------------------------------------|-------------|--------------|---------|-------|-------|
| 1. Public Land Survey              | T <u>5N</u> | R <u>11W</u> | _____   | _____ | _____ |
|                                    | T _____     | R _____      | _____   | _____ | _____ |
|                                    | T _____     | R _____      | _____   | _____ | _____ |
|                                    | T _____     | R _____      | _____   | _____ | _____ |
| 2. Property Controlling in Section | S _____     | T _____      | R _____ | _____ | _____ |
|                                    | S _____     | T _____      | R _____ | _____ | _____ |
| 3. Miscellaneous Property in Sec.  | S _____     | T _____      | R _____ | _____ | _____ |
|                                    | S _____     | T _____      | R _____ | _____ | _____ |

4. Lot No. \_\_\_\_\_, Recorded Plat \_\_\_\_\_

5. Private Claims \_\_\_\_\_

STATE OF MICHIGAN  
COUNTY OF KENT  
RECORDED FOR RECORDS

96 AUG -6 AM 9:45


REC. OF DEEDS

9292

Register of Deeds Stamp & File Number

I, Randy Kolehouse, in a field survey on December 27 19 95, do hereby certify that under requirements of P.A. 74 Michigan P.A. of 1970, the corner points mentioned in lines 1 and 2 above were in conformance with regulations and rules therefore as required in the current manual of survey instructions of the United States Department of the interior, Bureau of Land Management or by a decree of a Court of Law and/or that the corner points mentioned in lines 3, 4 and 5 above were in conformance with the rules of the Michigan Board of Land Surveyors or by a Decree of a Court of Law; established, re-established, monumented, re-monumented, recovered, found as expressed below:

**NOTE: Not more than 4 corners, all in the same town and range, may be recorded on this certificate.**

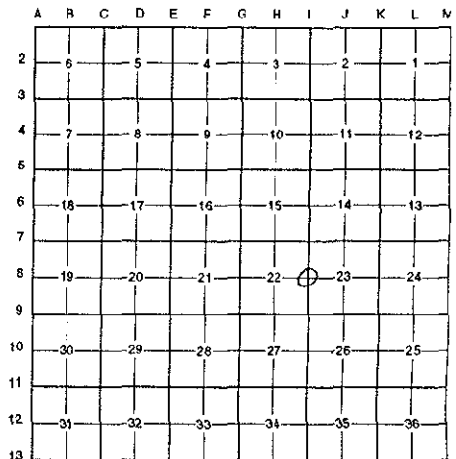

**A. Description of original monument and accessories and/or subsequent restoration:**

|     |      |                |                    |   |
|-----|------|----------------|--------------------|---|
| I-8 | 1831 | G.L.O. Notes   | Mullett            | Set Post                                  |
|     | 1963 | Witness Map    | K.C. Surveyor      | "+" in Pavement                           |
|     | 1974 | L.C.R.C. #718  | Nederveld & Jonker | Iron in Monument Box                      |
|     | 1981 | L.C.R.C. #1806 | William Byl        | Fnd. Iron in Mon. Box / Set K.C. Monument |
|     | 1994 | L.C.R.C. #7197 | Glaza & Associates | K.C. Monument                             |

P.A. 345 1990 KENT COUNTY  
PEER APPROVED 3/7/96  
CHAIRMAN Randy Kolehouse

This corner was originally approved by the Kent County Remonumentation Peer Group and monumented by William Byl on 2/24/81 and was recorded per L.C.R.C. #1806.

**B. Description of corner evidence found and/or method applied in restoring or reestablishing corner:**

I-8 Found a Standard Kent County Monument 1" M/L West of the C/L of Hanna Lake Avenue (bit.) running N & S per L.C.R.C.'s #1806 and #7197 as set by William Byl in place of a 1-1/2" iron in a monument box he found that checked L.C.R.C. #718.

L.C.R.C. #1806


L.C.R.C. #7197

|  |  |
|--|--|
| Nail & tag, N side Power Pole W 30.36'                     | Nail & K.C. remon. tag in N side P. pole West 30.36'         |
| Nail & tag, N side 10" Hickory N 85° E 56.00'              | Nail & K.C. remon. tag in N side 12" Hickory N 85° E 56.02'  |
| Nail & tag, W side 16" Hickory N 45° E 88.30'              | Nail & K.C. remon. tag in W side 18" Hickory N 45° E 88.30'  |
| Nail & tag, W side 12" Hawthorn S 35° E 90.74' (m. 90.85') | Nail & K.C. remon. tag in W side 14" Hawthorn S 35° E 90.85' |

The selected location is accepted by me and is generally accepted by professional surveyors as the best available evidence of the position of the original corner.

**C. Description of monument for corner and accessories established to perpetuate locating the position of the corner:**

- I-8 Standard Kent County Monument
- Nail & K.C. remon. tag in N side P. pole West 30.36'
  - Nail & K.C. remon. tag in N side 12" Hickory N 85° E 56.02'
  - Nail & K.C. remon. tag in W side 18" Hickory N 45° E 88.30'
  - Nail & K.C. remon. tag in W side 18" Hawthorn S 35° E 90.85'

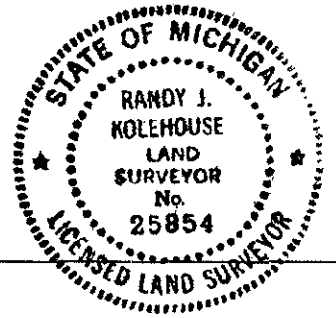

Signed by Randy J. Kolehouse  
EARTH TECH

Date 7/23/96

Surveyor's Michigan License No. 25854