

**SURVEY & REMONUMENTATION**

FEB 14 1997

COMMISSION

**LAND CORNER RECORDATION CERTIFICATE**  
**Filing Requirement of Act 74, Mich. P.A. 1970**  
**KENT COUNTY REMONUMENTATION**

For corners in

Kent (County)	Located in:	Gaines Township	Corner Code #
1. Public Land Survey	T <u>5N</u>	R <u>11W</u>	<u>I-9</u>
	T _____	R _____	_____
	T _____	R _____	_____
	T _____	R _____	_____
2. Property Controlling in Section	S _____	T _____	R _____
	S _____	T _____	R _____
3. Miscellaneous Property in Sec.	S _____	T _____	R _____
	S _____	T _____	R _____

REG. OF DEEDS

96 AUG -8 AM 8:45


STATE OF MICHIGAN  
COUNTY OF KENT  
RECEIVED FOR RECORD

9293

Register of Deeds Stamp & File Number

4. Lot No. \_\_\_\_\_, Recorded Plat \_\_\_\_\_
5. Private Claims \_\_\_\_\_

I, Randy Kolehouse, in a field survey on December 27 19 95, do hereby certify that under requirements of P.A. 74 Michigan P.A. of 1970, the corner points mentioned in lines 1 and 2 above were in conformance with regulations and rules therefore as required in the current manual of survey instructions of the United States Department of the interior, Bureau of Land Management or by a decree of a Court of Law and/or that the corner points mentioned in lines 3, 4 and 5 above were in conformance with the rules of the Michigan Board of Land Surveyors or by a Decree of a Court of Law; established, re-established, monumented, re-monumented, recovered, found as expressed below:

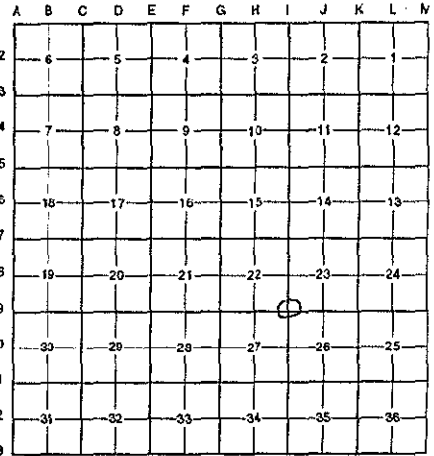

**NOTE: Not more than 4 corners, all in the same town and range, may be recorded on this certificate.**

**A. Description of original monument and accessories and/or subsequent restoration:**

I-9	1831	G.L.O. Notes	Mullett	Set Post	P.A. 345 1990 KENT COUNTY
	1966	Witness Map	K.C. Surveyor	"X" in Concrete	PEER APPROVED 3/2/96
	1974	L.C.R.C. #642	Exxel Engineering	Iron in Monument Box	CHAIRMAN <u>Jerry Huber</u>
	1976	L.C.R.C. #999	Medema, Van Kooten & Assoc.	Iron in Monument Box	
	1980	L.C.R.C. #1737	Williams & Works	Fnd. Iron in Mon. Box / Set K.C. Monument	
	1994	L.C.R.C. #7198	Giaza & Associates	K.C. Monument	

This corner was originally approved by the Kent County Remonumentation Peer Group and monumented by Williams & Works on 12/18/80 and was recorded per L.C.R.C. #1737.

**B. Description of corner evidence found and/or method applied in restoring or reestablishing corner:**

I-9 Found a Standard Kent County Monument at the C/L intersection of Hanna Lake Avenue (bit.) running N & S and 92nd Street (bit.) running E & W per L.C.R.C.'s #1737 and #7198 as set by Williams & Works in place of a 3/4" iron in a monument box that checked L.C.R.C.'s #642 and #999.

**L.C.R.C. #1737**

Nail & K.C. Remon. Tag in East Side 36" Oak N 05° E 155.22'  
 Nail & K.C. Remon. Tag in NE Side Power Pole N 35° W 69.82'  
 "X" Cut Top of Conc. Curb S 43° W 40.70'

**L.C.R.C. #7198**

Nail & K.C. remon. tag in East side 36" Oak N 05° E 155.22'  
 Nail & K.C. remon. tag in NE side P. pole N 35° W 69.82'  
 Nail & K.C. remon. tag in NW side guy pole N 40° E 70.25'  
 Nail & K.C. remon. tag in SE side P. pole S 20° W 91.25'

The selected location is accepted by me and is generally accepted by professional surveyors as the best available evidence of the position of the original corner.


**C. Description of monument for corner and accessories established to perpetuate locating the position of the corner:**

I-9 Standard Kent County Monument

Nail & K.C. remon. tag in East side 36" Oak N 05° E 155.22'  
 Nail & K.C. remon. tag in NE side P. pole N 35° W 69.82'  
 Nail & K.C. remon. tag in NW side Guy pole N 40° E 70.25'  
 Nail & K.C. remon. tag in SE side P. pole S 20° W 91.25'

Signed by Randy J. Kolehouse  
 EARTH TECH

Date 7/23/96

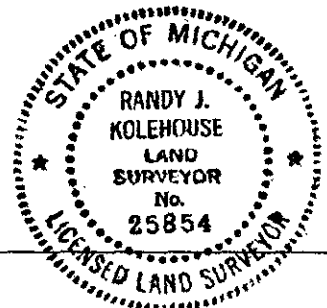

Surveyor's Michigan License No. 25854