

SURVEY & REMONUMENTATION

FEB 14 1997

COMMISSION

LAND CORNER RECORDATION CERTIFICATE
Filing Requirement of Act 74, Mich. P.A. 1970
KENT COUNTY REMONUMENTATION

For corners in

<u>Kent</u> (County)	Located in: <u>Gaines</u> Township	Corner Code #
1. Public Land Survey	T <u>5N</u> R <u>11W</u>	<u>I-12</u>
	T _____ R _____	_____
	T _____ R _____	_____
	T _____ R _____	_____
2. Property Controlling in Section	S _____ T _____ R _____	_____
	S _____ T _____ R _____	_____
3. Miscellaneous Property in Sec.	S _____ T _____ R _____	_____
	S _____ T _____ R _____	_____

STATE OF MICHIGAN
 COUNTY OF KENT
 RECEIVED FOR RECORD
 96 AUG -8 AM 8:46
 REG. OF DEEDS
Lucy Bond
9296
 Register of Deeds Stamp & File Number

4. Lot No. _____, Recorded Plat _____
 5. Private Claims _____


I, Randy Kolehouse, in a field survey on January 3 19 96, do hereby certify that under requirements of P.A. 74 Michigan P.A. of 1970, the corner points mentioned in lines 1 and 2 above were in conformance with regulations and rules therefore as required in the current manual of survey instructions of the United States Department of the interior, Bureau of Land Management or by a decree of a Court of Law and/or that the corner points mentioned in lines 3, 4 and 5 above were in conformance with the rules of the Michigan Board of Land Surveyors or by a Decree of a Court of Law; established, re-established, monumented, re-monumented, recovered, found as expressed below:

NOTE: Not more than 4 corners, all in the same town and range, may be recorded on this certificate.

A. Description of original monument and accessories and/or subsequent restoration:

I-12	1831	G.L.O. Notes	Mullett	Set Post
	1964	Witness Map	K.C. Surveyor	1" Iron
	1972	L.C.R.C. #337	Spicer	1" Iron
	1982	L.C.R.C. #2833	Jonker Land Surveys	Fnd. 1" Iron / Set K.C. Monument
	1994	L.C.R.C. #7187	Glaza & Associates	K.C. Monument

P.A. 345 1990 KENT COUNTY
 PEER APPROVED 3/7/96
 CHAIRMAN Harry Duke

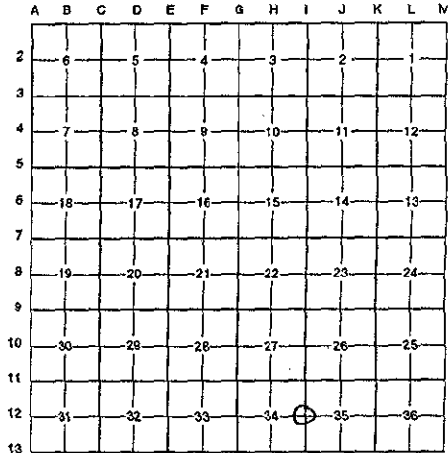

This corner was originally approved by the Kent County Remonumentation Peer Group and monumented by Rob Jonker on 4/20/82 and was recorded per L.C.R.C. #2833.

B. Description of corner evidence found and/or method applied in restoring or reestablishing corner:

I-12 Found a Standard Kent County Monument 1' West of the C/L of Hanna Lake Avenue (bit.) running North and South on line of a tree row running East and West per L.C.R.C.'s #2833 and #7187 as set by Rob Jonker in place of a 1" iron over a 3/4" iron in ring of stones 18" below grade that checked L.C.R.C. #337 and K.C. Surveyor's records.

L.C.R.C. #2833

Remon. tag on N side 9" x 18" W. Cherry S 65° W 33.63'
 Remon. tag on NW side 12" Maple S 38° W 64.18'
 Remon. tag on N side 12" Pignut N 8° E 46.11' (m. 45.95)
 Remon. tag on NE side 9" Locust N 30° W 49.21' (m. 49.37')

L.C.R.C. #7187

K.C. remon tag & nail in N side 9" x 18" W. Cherry S 65° W 33.63'
 K.C. remon tag & nail in NW side 14" Maple S 38° W 64.18'
 K.C. remon tag & nail in N side 18" Pignut N 88° E 45.95'
 K.C. remon tag & nail in NE side 14" Locust N 30° W 49.37'

The selected location is accepted by me and is generally accepted by professional surveyors as the best available evidence of the position of the original corner.

C. Description of monument for corner and accessories established to perpetuate locating the position of the corner:

I-12 Standard Kent County Monument

Nail & K.C. remon. tag on N side 9" x 18" W. Cherry S 65° W 33.63'
 Nail & K.C. remon. tag on NW side 14" Maple S 38° W 64.18'
 Nail & K.C. remon. tag on N side 18" Pignut N 88° E 45.95'
 Nail & K.C. remon. tag on NE side 14" Locust N 30° W 49.37'

Signed by Randy J. Kolehouse
 EARTH TECH

Date 7/23/96

Surveyor's Michigan License No. 25854

