

SURVEY & REMONUMENTATION

FEB 14 1997

COMMISSION

LAND CORNER RECORDATION CERTIFICATE
Filing Requirement of Act 74, Mich. P.A. 1970
KENT COUNTY REMONUMENTATION

For corners in

Kent (County)	Located in: Gains Township	Corner Code #
1. Public Land Survey	T <u>5N</u> R <u>11W</u>	<u>J-1</u>
	T _____ R _____	_____
	T _____ R _____	_____
	T _____ R _____	_____
2. Property Controlling in Section	S _____ T _____ R _____	_____
	S _____ T _____ R _____	_____
3. Miscellaneous Property in Sec.	S _____ T _____ R _____	_____
	S _____ T _____ R _____	_____

STATE OF MICHIGAN
 COUNTY OF KENT
 RECEIVED FOR RECORD
 96 AUG -8 AM 8:46
 REG. OF DEEDS
[Signature]

9298

Register of Deeds Stamp & File Number

4. Lot No. _____, Recorded Plat _____
 5. Private Claims _____

	A	B	C	D	E	F	G	H	I	J	K	L	N
2	6		5		4		3		2		1		
3													
4	7		8		9		10		11		12		
5													
6	18		17		16		15		14		13		
7													
8	19		20		21		22		23		24		
9													
10	30		29		28		27		26		25		
11													
12	31		32		33		34		35		36		
13													

I, Randy Kolehouse, in a field survey on January 2 19 96, do hereby certify that under requirements of P.A. 74 Michigan P.A. of 1970, the corner points mentioned in lines 1 and 2 above were in conformance with regulations and rules therefore as required in the current manual of survey instructions of the United States Department of the Interior, Bureau of Land Management or by a decree of a Court of Law and/or that the corner points mentioned in lines 3, 4 and 5 above were in conformance with the rules of the Michigan Board of Land Surveyors or by a Decree of a Court of Law; established, re-established, monumented, re-monumented, recovered, found as expressed below:

NOTE: Not more than 4 corners, all in the same town and range, may be recorded on this certificate.

A. Description of original monument and accessories and/or subsequent restoration:

J-1	This corner was not originally set by the G.L.O.			
	1963 Witness Map	K.C. Surveyor	Boat Spike	
	1977 L.C.R.C. #1042	Exxel Engineering	"T" Iron	
	1983 L.C.R.C. #3475	William Byl	Fnd. "T" Iron / Set K.C. Monument	
	1989 L.C.R.C. #5002	J. Bueche	K.C. Monument	

P.A. 345 1990 KENT COUNTY
 PEER APPROVED 3/7/96
 CHAIRMAN [Signature]

Note: This corner is not common with J-13, T6N, R11W.

This corner was originally approved by the Kent County Remonumentation Peer Group and monumented by William Byl on 4/22/83 and was recorded per L.C.R.C. #3475.

B. Description of corner evidence found and/or method applied in restoring or reestablishing corner:

J-1 Found a Standard Kent County Monument on the C/L of 60th Avenue (bit.) running East & West on line of a tree row running South 13' East of a fence line running North as set by William Byl in place of a 24" "T" iron he found on the Town line 13.11' East of J-13, T6N, R11W, that checked L.C.R.C. #1042 and K.C. Surveyor's records.

L.C.R.C. #3475

L.C.R.C. #5002


nail & tag N sd. 24" Maple N-65-W 80.21'
 nail & tag W sd. MBT Pole S-10-W 32.82'
 nail & tag S sd. 16" Willow S-45-E 49.45'
 nail & tag S sd. 16" Ash N-70-E 87.64'
 S 1/4 cor. Sec. 35, 6-11 (Kent Co. Mon.) W 13.10'

Nail & Remon Tag N side 26" Maple N 65° W 80.21' (m. 80.20')
 Nail & Remon Tag W side MBT pole S 10° W 32.82' (m. 32.74')
 Nail & Remon Tag N side 20" Willow S 45° E 49.45' (m. 50.99')
 Nail & Remon Tag S side 18" Ash N 70° E 87.64' (m. 87.58')
 K.C. Mon (J-13, T6N, R11W) West 13.10' (m. 13.11')

The selected location is accepted by me and is generally accepted by professional surveyors as the best available evidence of the position of the original corner.

C. Description of monument for corner and accessories established to perpetuate locating the position of the corner:

J-1 Standard Kent County Monument on the Town Line
 Nail & K.C. remon. tag on N side 26" Maple N 65° W 80.20'
 Nail & K.C. remon. tag on W side MBT pole S 10° W 32.74'
 Nail & K.C. remon. tag on N side 16" Willow S 40° E 50.99'
 Nail & K.C. remon. tag on S side 18" Ash N 70° E 87.58'
 K.C. Mon. S 1/4 cor. 33, T6N, R11W, West 13.11'
 Nail & K.C. remon. tag on W side Twin 10" Maple N 26° W 31.55'

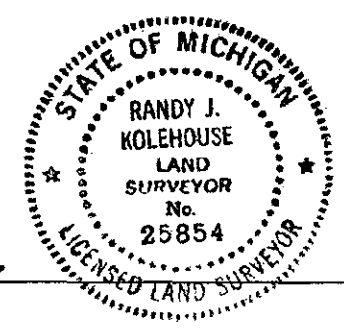

Signed by Randy J. Kolehouse Date 7/23/96
 EARTH TECH
 Surveyor's Michigan License No. 25854