

FEB 14 1997

COMMISSION

LAND CORNER RECORDATION CERTIFICATE
Filing Requirement of Act 74, Mich. P.A. 1970
KENT COUNTY REMONUMENTATION

For corners in

Table with columns: Kent (County), Located in: Gains Township, Corner Code #. Rows include Public Land Survey, Property Controlling in Section, Miscellaneous Property in Sec.

Register of Deeds Stamp & File Number. Includes date 96 AUG - 8 AM 8:46 and handwritten file number 9299.


4. Lot No. \_\_\_\_\_, Recorded Plat \_\_\_\_\_
5. Private Claims \_\_\_\_\_

I, Randy Kolehouse, in a field survey on December 26 19 95, do hereby certify that under requirements of P.A. 74 Michigan P.A. of 1970, the corner points mentioned in lines 1 and 2 above were in conformance with regulations and rules therefore as required in the current manual of survey instructions of the United States Department of the interior, Bureau of Land Management or by a decree of a Court of Law and/or that the corner points mentioned in lines 3, 4 and 5 above were in conformance with the rules of the Michigan Board of Land Surveyors or by a Decree of a Court of Law; established, re-established, monumented, re-monumented, recovered, found as expressed below:

NOTE: Not more than 4 corners, all in the same town and range, may be recorded on this certificate.

A. Description of original monument and accessories and/or subsequent restoration:

Table with columns: Year (1831, 1960, 1976, 1981, 1994), Description (G.L.O. Notes, Witness Map, L.C.R.C. #909, #2284, #7158), Surveyor/Engineer (Mullett, K.C. Surveyor, Exxel Engineering, Nederveld & Jonker, Glaza & Associates), Monument Type (Set Post, 'X' in Concrete, Iron in Monument Box, Fnd. Iron in Monument Box / Set K.C. Monument, K.C. Monument).

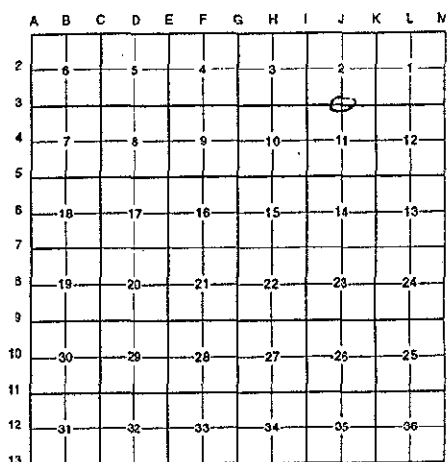

P.A. 345 1990 KENT COUNTY PEER APPROVED 3/21/96 CHAIRMAN Randy Kolehouse

This corner was originally approved by the Kent County Remonumentation Peer Group and monumented by Nederveld & Jonker on 8/17/81 and was recorded per L.C.R.C. #2284.

B. Description of corner evidence found and/or method applied in restoring or reestablishing corner:

J-3 Found a Standard Kent County Monument on the C/L of 68th Street (bit.) running East and West per L.C.R.C.'s #2284 and #7158 as set by Nederveld & Jonker in place of an iron they found in a monument box which checked L.C.R.C. #909 and K.C. Surveyor's records.

Table comparing L.C.R.C. #2284 and L.C.R.C. #7158. Columns: L.C.R.C. #2284, L.C.R.C. #7158. Row: SW corner of garage fnd. N 08° E 70.89'. Details include Nail & K.C. remon. tag in SW side P. pole N 45° W 31.50', NW side P. pole S 35° W 30.77', and NE side P. pole S 70° E 73.78'.

The selected location is accepted by me and is generally accepted by professional surveyors as the best available evidence of the position of the original corner.

C. Description of monument for corner and accessories established to perpetuate locating the position of the corner:

J-3 Standard Kent County Monument

- SW corner of garage foundation N 08° E 70.89'
Nail & K.C. remon. tag in SW side P. pole N 45° W 31.50'
Nail & K.C. remon. tag in NW side P. pole S 35° W 30.77'
Nail & K.C. remon. tag in NE side P. pole S 70° E 73.78'

Signed by Randy J. Kolehouse EARTH TECH

Date 7/23/96

Surveyor's Michigan License No. 25854

