

JAN 23 1996

\$7.00
\$2.00

COMMISSION

LAND CORNER RECORDATION CERTIFICATE
Filing Requirement of Act 74, Mich. P.A. 1970
KENT COUNTY REMONUMENTATION

For corners in

Kent (County)	Located in:	Corner Code #
1. Public Land Survey	T <u>5N</u> R <u>11W</u>	<u>J-4</u>
	T _____ R _____	_____
	T _____ R _____	_____
	T _____ R _____	_____
2. Property Controlling in Section	S _____ T _____ R _____	_____
	S _____ T _____ R _____	_____
3. Miscellaneous Property in Sec.	S _____ T _____ R _____	_____
	S _____ T _____ R _____	_____


STATE OF MICHIGAN
COUNTY OF KENT
RECEIVED FOR RECORD

95 DEC 28 PM 2:21

REG. OF DEEDS
8916

Register of Deeds Stamp & File Number

- 4. Lot No. _____, Recorded Plat _____
- 5. Private Claims _____

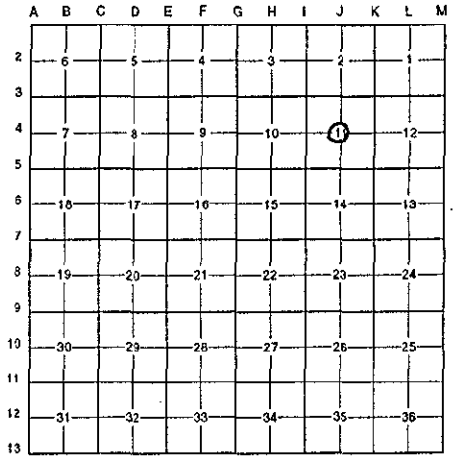

I, Randy Kolehouse, in a field survey on May 15 19 95, do hereby certify that under requirements of P.A. 74 Michigan P.A. of 1970, the corner points mentioned in lines 1 and 2 above were in conformance with regulations and rules therefore as required in the current manual of survey instructions of the United States Department of the Interior, Bureau of Land Management or by a decree of a Court of Law and/or that the corner points mentioned in lines 3, 4 and 5 above were in conformance with the rules of the Michigan Board of Land Surveyors or by a Decree of a Court of Law; established, re-established, monumented, re-monumented, recovered, found as expressed below:

NOTE: Not more than 4 corners, all in the same town and range, may be recorded on this certificate.

A. Description of original monument and accessories and/or subsequent restoration:

J-4 This corner was not originally set by the G.L.O.

1950-1969	Survey Notes	Williams & Works	Found Iron
1956	Wit. Map	K.C. Surveyor	Conc. Mon. (Wit. Checks with Williams & Works Iron)
1974	L.C.R.C. #721	Nederveld	Found 1/2" Iron

P.A. 345 1990 KENT COUNTY
PEER APPROVED 10/26/95
CHAIRMAN Randy Kolehouse

B. Description of corner evidence found and/or method applied in restoring or reestablishing corner:

J-4 Found a 1" iron per L.C.R.C. #721 3.5' North and 0.2' East of the intersection of 1/4 lines. This position is confirmed by Exxel Engineering survey records and has been accepted as the Historical Center Section. This iron is on C/L of road running North and South and on power lines running East and West.


L.C.R.C. #721

- Spike in 12" Aspen NNW 141.14'
- Spike in 6" Apple SW 62.21'

C. Description of monument for corner and accessories established to perpetuate locating the position of the corner:

J-4 Replaced the 1" iron with a Standard 4" x 30" Kent County Monument.

- Nail & K.C. remon. tag in W face 10" Apple N 20° W 83.91'
- Nail & K.C. remon. tag in E face 10" Poplar N 10° W 141.55'
- Nail & K.C. remon. tag in W face 8" Apple S 30° W 62.16'
- Nail & K.C. remon. tag in E face 10" Ash S 10° W 150.27'

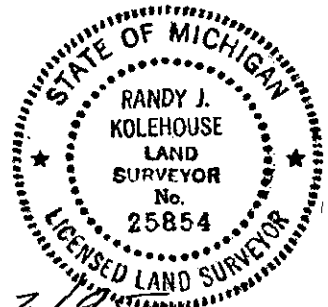

Signed by Randy J. Kolehouse Date 12/22/95
EARTH TECH

Surveyor's Michigan License No. 25854