

**SURVEY & REMONUMENTATION**

FEB 14 1997

**COMMISSION**

**LAND CORNER RECORDATION CERTIFICATE**  
**Filing Requirement of Act 74, Mich. P.A. 1970**  
**KENT COUNTY REMONUMENTATION**


For corners in

Kent (County)	Located in: Gaines Township	Corner Code #
1. Public Land Survey	T <u>5N</u> R <u>11W</u>	<u>J-5</u>
	T _____ R _____	_____
	T _____ R _____	_____
	T _____ R _____	_____
2. Property Controlling in Section	S _____ T _____ R _____	_____
	S _____ T _____ R _____	_____
3. Miscellaneous Property in Sec.	S _____ T _____ R _____	_____
	S _____ T _____ R _____	_____

STATE OF MICHIGAN  
 COUNTY OF KENT  
 RECEIVED FOR RECORD  
 96 AUG -9 AM 8:46  
 REG. OF DEEDS  
*Lucy St. Grand*  
 9300  
 Register of Deeds Stamp & File Number

4. Lot No. \_\_\_\_\_, Recorded Plat \_\_\_\_\_  
 5. Private Claims \_\_\_\_\_

I, Randy Kolehouse, in a field survey on December 26 19 95, do hereby certify that under requirements of P.A. 74 Michigan P.A. of 1970, the corner points mentioned in lines 1 and 2 above were in conformance with regulations and rules therefore as required in the current manual of survey instructions of the United States Department of the interior, Bureau of Land Management or by a decree of a Court of Law and/or that the corner points mentioned in lines 3, 4 and 5 above were in conformance with the rules of the Michigan Board of Land Surveyors or by a Decree of a Court of Law; established, re-established, monumented, re-monumented, recovered, found as expressed below:

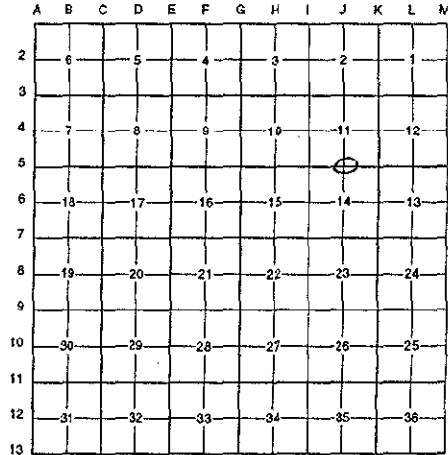

NOTE: Not more than 4 corners, all in the same town and range, may be recorded on this certificate.

A. Description of original monument and accessories and/or subsequent restoration:

J-5	1831	G.L.O. Notes	Mullett	Set Post
	1956	Witness Map	K.C. Surveyor	3/4" Iron
	1973	L.C.R.C. #415	Madema, Van Kooten & Assoc.	1/2" Iron
	1980	L.C.R.C. #1741	Williams & Works	Fnd. 1/2" Iron in 1" Iron / Set K.C. Monument
	1994	L.C.R.C. #7162	Glaza & Associates	K.C. Monument

P.A. 345 1990 KENT COUNTY  
 PEER APPROVED 9/7/96  
 CHAIRMAN Fanny Huber

This corner was originally approved by the Kent County Remonumentation Peer Group and monumented by Williams & Works on 12/17/80 and was recorded per L.C.R.C. #1741.

B. Description of corner evidence found and/or method applied in restoring or reestablishing corner:

J-5 Found a Standard Kent County Monument on the C/L of 76th Street (bit.) running East and West and C/L of Hammond Avenue (bit.) running North as set by Williams & Works in place of a 1/2" iron they found which checked L.C.R.C. #415 and K.C. Surveyor's records.

L.C.R.C. #1741

- S.W. Cor. Hse. Fnd. N 47° E 102.45'
- N.W. Cor. Garg. to Hse. #3614 Brick S 25° E 118.44'
- N.E. Cor. Building S 25° W 151.36'
- Nail & K.C. Remon. Tag in West Side Power Pole South 53.48'
- Nail & K.C. Remon Tag in East Side Power Pole N 27° W 104.65'
- C/L Fence Post (N. End of Fence) S 84° W 135.87'
- Nail South & West 3.00'

L.C.R.C. #7162


- SW corner house foundation N 47° E 102.45'
- NW corner garage to house #3614 brick S 25° E 118.44'
- N.E. corner building (new) S 20° W 132.54'
- Nail & K.C. remon tag in West side P. pole South 53.54'
- Nail & K.C. remon tag in East side P. pole N 27° W 104.65'

The selected location is accepted by me and is generally accepted by professional surveyors as the best available evidence of the position of the original corner.

C. Description of monument for corner and accessories established to perpetuate locating the position of the corner:

J-5 Standard Kent County Monument

- SW corner house foundation N 47° E 102.45'
- NW corner garage to house #3614 brick S 25° E 118.44'
- N.E. corner building (new) S 20° W 132.54'
- Nail & K.C. remon. tag in West side P. pole South 53.54'
- Nail & K.C. remon. tag in East side P. pole N 27° W 104.65'

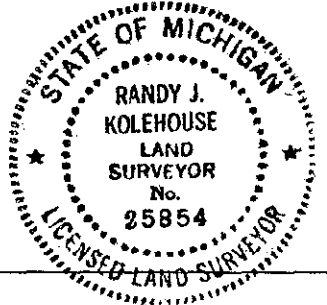

Signed by Randy J. Kolehouse  
 EARTH TECH

Date 7/23/96

Surveyor's Michigan License No. 25854