

\$7.00
\$2.00

Survey &
Remonumentation

JAN 23 1996

LAND CORNER RECORDATION CERTIFICATE
Filing Requirement of Act 74, Mich. P.A. 1970
KENT COUNTY REMONUMENTATION

For corners in **COMMISSION**

Kent (County)	Located in:	Corner Code #
1. Public Land Survey	T <u>5N</u> R <u>11W</u>	<u>J-6</u>
	T _____ R _____	_____
	T _____ R _____	_____
	T _____ R _____	_____
2. Property Controlling in Section	S _____ T _____ R _____	_____
	S _____ T _____ R _____	_____
3. Miscellaneous Property in Sec.	S _____ T _____ R _____	<u>Seg. 2</u>
	S _____ T _____ R _____	_____

STATE OF MICHIGAN
COUNTY OF KENT
RECEIVED FOR RECORD

95 DEC 28 PM 2: 22

REG. OF DEEDS
Lucy St. Bond

8917

Register of Deeds Stamp & File Number

- 4. Lot No. _____, Recorded Plat _____
- 5. Private Claims _____

I, Randy Kolehouse, in a field survey on May 15 19 95, do hereby certify that under requirements of P.A. 74 Michigan P.A. of 1970, the corner points mentioned in lines 1 and 2 above were in conformance with regulations and rules therefore as required in the current manual of survey instructions of the United States Department of the Interior, Bureau of Land Management or by a decree of a Court of Law and/or that the corner points mentioned in lines 3, 4 and 5 above were in conformance with the rules of the Michigan Board of Land Surveyors or by a Decree of a Court of Law; established, re-established, monumented, re-monumented, recovered, found as expressed below:

NOTE: Not more than 4 corners, all in the same town and range, may be recorded on this certificate.

	A	B	C	D	E	F	G	H	I	J	K	L	M
2	6		5		4		3		2		1		
3													
4	7		8		9		10		11		12		
5													
6	16		17		18		15		14		13		
7													
8	19		20		21		22		23		24		
9													
10	30		29		28		27		26		25		
11													
12	31		32		33		34		35		36		
13													

A. Description of original monument and accessories and/or subsequent restoration:

J-6 This corner was not originally set by the G.L.O.

1987	Survey Notes	Exxel Engineering	Set 1/2" Iron in Root of 6" Elm at Int. of 1/4 Lines
1993	L.C.R.C. #6864	Chris Marschall	Found 1/2" Iron at Int. of 1/4 Lines

P.A. 345 1990 KENT COUNTY
PEER APPROVED 10/26/95
CHAIRMAN Harry Huber

B. Description of corner evidence found and/or method applied in restoring or reestablishing corner:

J-6 Found a 1/2" iron with cap per L.C.R.C. #6864 within 0.1' of true position and verified 1/4 line measurements with LMN and Exxel Eng. Accepted iron as Center Section.

L.C.R.C. #6864A


Nail and Remon tag in SE side of 20" Shagbark Hickory N 40° E 105.09'
Nail and Remon tag in SE side of 5" Ash S 50° W 35.90'
Nail and Remon tag in SE side of 3" Hickory N 85° E 14.12'
SE corner of small guage RR Rail Fence Corner Post
Set in a Concrete Base (at concrete base) N 60° W 7.68'
East and West Fence North 3' ±
North and South Fence West 7' ±

SURVEY &
REMONUMENTATION
MAY 16 1997
COMMISSION

C. Description of monument for corner and accessories established to perpetuate locating the position of the corner:

J-6 Replaced the 1/2" iron with a Standard 4" x 30" Kent County Monument.

Nail & K.C. remon. tag in SE side of 20" Shagbark Hickory N 40° E 105.09'
Nail & K.C. remon. tag in SE side of 5" Ash S 50° W 35.90'
Nail & K.C. remon. tag in SE side of 3" Hickory N 85° E 14.12'
SE corner of small guage RR Rail Fence Corner Post
Set in a Concrete Base (at concrete base) N 60° W 7.68'
East and West Fence North 3' ±
North and South Fence West 7' ±

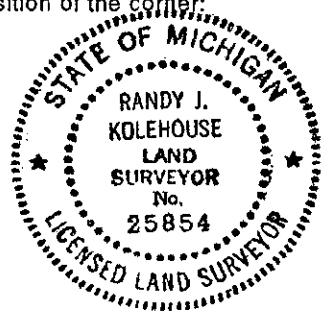

Signed by Randy J. Kolehouse Date 12/22/95
EARTH TECH

Surveyor's Michigan License No. 25854