

\$7.00  
\$2.00

JAN 23 1996

LAND CORNER RECORDATION CERTIFICATE  
Filing Requirement of Act 74, Mich. P.A. 1970  
KENT COUNTY REMONUMENTATION

For corners in **COMMISSION**

Kent (County)	Located in:	Corner Code #
1. Public Land Survey	T <u>5N</u> R <u>11W</u>	<u>J-8</u>
	T _____ R _____	_____
	T _____ R _____	_____
	T _____ R _____	_____
2. Property Controlling in Section	S _____ T _____ R _____	_____
	S _____ T _____ R _____	_____
3. Miscellaneous Property in Sec.	S _____ T _____ R _____	_____
	S _____ T _____ R _____	_____

STATE OF MICHIGAN  
COUNTY OF KENT  
RECEIVED FOR RECORD

95 DEC 28 PM 2:22

REG. OF DEEDS  
*Lucy Spauld*  
8918

Register of Deeds Stamp & File Number

4. Lot No. \_\_\_\_\_, Recorded Plat \_\_\_\_\_
5. Private Claims \_\_\_\_\_

I, Randy Kolehouse, in a field survey on May 19 19 95, do hereby certify that under requirements of P.A. 74 Michigan P.A. of 1970, the corner points mentioned in lines 1 and 2 above were in conformance with regulations and rules therefore as required in the current manual of survey instructions of the United States Department of the interior, Bureau of Land Management or by a decree of a Court of Law and/or that the corner points mentioned in lines 3, 4 and 5 above were in conformance with the rules of the Michigan Board of Land Surveyors or by a Decree of a Court of Law; established, re-established, monumented, re-monumented, recovered, found as expressed below:

NOTE: Not more than 4 corners, all in the same town and range, may be recorded on this certificate.

	A	B	C	D	E	F	G	H	I	J	K	L	M
2	6	5	4	3	2	1							
3													
4	7	8	9	10	11	12							
5													
6	18	17	16	15	14	13							
7													
8	19	20	21	22	23	24							
9													
10	30	29	28	27	26	25							
11													
12	31	32	33	34	35	36							
13													

A. Description of original monument and accessories and/or subsequent restoration:

J-8 This corner was not originally set by the G.L.O.

1926	Survey Notes	Williams & Works	Used Int. of Fences for Center
1966	Wit. Map	K.C. Surveyor	"X" of Fences is 2' South of E-W 1/4 Lines
1985	L.C.R.C. #4351	Jonker Land Surveys	Set Rebar at Int. of 1/4 Lines

B. Description of corner evidence found and/or method applied in restoring or reestablishing corner:

J-8 Found a capped rebar per L.C.R.C. #4351 at the intersection of fences as set by Jonker Land Surveys at intersection of 1/4 lines. This iron is within 0.1' of the intersection of 1/4 line and is accepted as Center of Section.

L.C.R.C. #4351


Set spike on the SW side 40" Oak S30°E 14.20'  
Set spike on the E side 6" Oak N0°E 16.92'  
Most easterly edge RR rail fence corner post S 40°W 3.16'

P.A. 345 1990 KENT COUNTY  
PEER APPROVED 10/26/95  
CHAIRMAN Harry Kuebel

C. Description of monument for corner and accessories established to perpetuate locating the position of the corner:

J-8 Replaced the capped iron with a Standard 4" x 30" Kent County Monument.

Spike in SW side 40" Oak S 30° E 14.20'  
Spike in E side 6" Hickory N 0° E 16.92'  
Most Easterly edge RR rail fence post S 40° W 3.16'  
Nail & K.C. remon. tag in S face 6" Hickory due East 20.40'

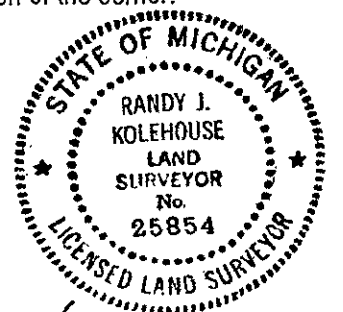

Signed by Randy J. Kolehouse Date 12/22/95  
EARTH TECH

Surveyor's Michigan License No. 25854