

SURVEY & REMONUMENTATION

FEB 14 1997

LAND CORNER RECORDATION CERTIFICATE
Filing Requirement of Act 74, Mich. P.A. 1970
KENT COUNTY REMONUMENTATION

For corners in **COMMISSION**

Kent (County)	Located in: Gaines Township	Corner Code #
1. Public Land Survey	T <u>5N</u> R <u>11W</u>	<u>J-9</u>
	T _____ R _____	_____
	T _____ R _____	_____
	T _____ R _____	_____
2. Property Controlling in Section	S _____ T _____ R _____	_____
	S _____ T _____ R _____	_____
3. Miscellaneous Property in Sec.	S _____ T _____ R _____	_____
	S _____ T _____ R _____	_____
4. Lot No. _____, Recorded Plat _____		
5. Private Claims _____		

STATE OF MICHIGAN
 COUNTY OF KENT
 RECEIVED FOR RECORD


96 AUG -8 AM 8:46

REG. OF DEEDS
Lucy Bond
 9302

Register of Deeds Stamp & File Number

I, Randy Kolehouse, in a field survey on December 26 19 95, do hereby certify that under requirements of P.A. 74 Michigan P.A. of 1970, the corner points mentioned in lines 1 and 2 above were in conformance with regulations and rules therefore as required in the current manual of survey instructions of the United States Department of the interior, Bureau of Land Management or by a decree of a Court of Law and/or that the corner points mentioned in lines 3, 4 and 5 above were in conformance with the rules of the Michigan Board of Land Surveyors or by a Decree of a Court of Law; established, re-established, monumented, re-monumented, recovered, found as expressed below:

NOTE: Not more than 4 corners, all in the same town and range, may be recorded on this certificate.

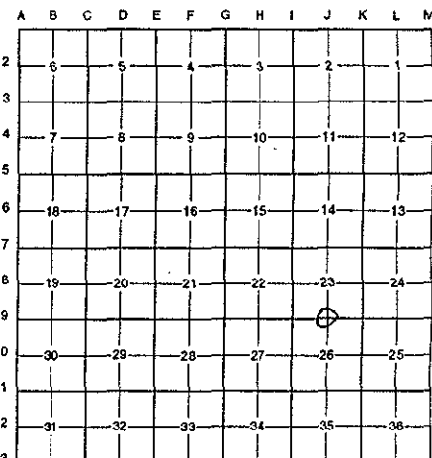

A. Description of original monument and accessories and/or subsequent restoration:

J-9	Description	Surveyor	Monument	P.A. 345 1990 KENT COUNTY
1831	G.L.O. Notes	Mullett	Set Post	PEER APPROVED <u>3/7/96</u> CHAIRMAN <u>Harry Huber</u>
N/A	Witness Map	K.C. Surveyor	Stone	
1974	L.C.R.C. #760	K.C. Surveyor	Boat Spike	
1976	L.C.R.C. #999	Medema, Van Kooten & Assoc.	"T" Iron	
1982	L.C.R.C. #2834	R. Jonker	Fnd. "T" Iron / Set K.C. Monument	
1994	L.C.R.C. #7169	Glaza & Associates	K.C. Monument	

This corner was originally approved by the Kent County Remonumentation Peer Group and monumented by R. Jonker on 4/22/82 and was recorded per L.C.R.C. #2834.

B. Description of corner evidence found and/or method applied in restoring or reestablishing corner:

J-9 Found a Standard Kent County Monument in the C/L of 92nd Street (bit.) running East & West on line of a tree row running North & South per L.C.R.C.'s #2834 and #7169 as set by Rob Jonker in place of a "T" iron over a "+" in old pavement (8" below surface) he found that checked L.C.R.C.'s #999 and #760.


L.C.R.C. #2834	L.C.R.C. #7169
NW cor. hse. found S 25° E 108.0'	NW corner of house foundation S 25° E 108.00'
SW cor. hse. found N 15° E 109.9'	SW corner of house foundation N 15° E 109.63'
NE cor. gar. found S 40° E 145.70'	NE corner of garage foundation S 40° E 145.70'
Remon. tag on E side p. pole N 05° W 61.72'	K.C. remon tag & nail in E side P. pole N 05° W 61.72'
Remon. tag on S side sign post S 75° W 114.77'	

The selected location is accepted by me and is generally accepted by professional surveyors as the best available evidence of the position of the original corner.

C. Description of monument for corner and accessories established to perpetuate locating the position of the corner:

J-9 Standard Kent County Monument

NW corner of house foundation S 25° E 108.00'
 SW corner of house foundation N 15° E 109.63'
 NE corner of garage foundation S 40° E 145.70'
 Nail & K.C. remon. tag on E side P. pole N 05° W 61.72'

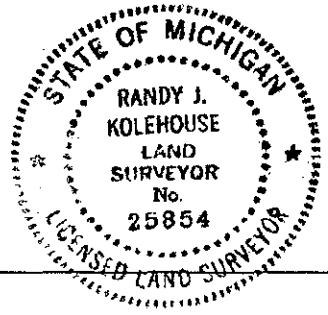

Signed by Randy J. Kolehouse Date 7/23/96
 EARTH TECH

Surveyor's Michigan License No. 25854