

FEB 14 1997

COMMISSION

LAND CORNER RECORDATION CERTIFICATE
Filing Requirement of Act 74, Mich. P.A. 1970
KENT COUNTY REMONUMENTATION

For corners in

Kent (County)	Located in: Gaines Township	Corner Code #
1. Public Land Survey	T <u>5N</u> R <u>11W</u>	<u>J-11</u>
	T _____ R _____	_____
	T _____ R _____	_____
	T _____ R _____	_____
2. Property Controlling in Section	S _____ T _____ R _____	_____
	S _____ T _____ R _____	_____
3. Miscellaneous Property in Sec.	S _____ T _____ R _____	_____
	S _____ T _____ R _____	_____

STATE OF MICHIGAN
 COUNTY OF KENT
 RECEIVED FOR RECORD

96 AUG -8 AM 8:46

REG. OF DEEDS
[Signature]
9303

Register of Deeds Stamp & File Number

4. Lot No. _____, Recorded Plat _____
 5. Private Claims _____

I, Randy Kolehouse, in a field survey on December 26 19 95, do hereby certify that under requirements of P.A. 74 Michigan P.A. of 1970, the corner points mentioned in lines 1 and 2 above were in conformance with regulations and rules therefore as required in the current manual of survey instructions of the United States Department of the Interior, Bureau of Land Management or by a decree of a Court of Law and/or that the corner points mentioned in lines 3, 4 and 5 above were in conformance with the rules of the Michigan Board of Land Surveyors or by a Decree of a Court of Law; established, re-established, monumented, re-monumented, recovered, found as expressed below:

NOTE: Not more than 4 corners, all in the same town and range, may be recorded on this certificate.

A. Description of original monument and accessories and/or subsequent restoration:

J-11	1831	G.L.O. Notes	Mullett	Set Post
	1953	Witness Map	K.C. Surveyor	Monument Box
	1974	L.C.R.C. #760	Exxel Engineering	3/4" Iron in Monument Box
	1982	L.C.R.C. #2835	Jonker Land Surveys	Fnd. 3/4" Iron in Mon. Box / Set
	1994	L.C.R.C. #7203	Glaza & Associates	K.C. Monument

P.A. 345 1990 KENT COUNTY

PEER APPROVED 3/7/96
 CHAIRMAN Randy Kolehouse
 K.C. Monument in Mon. Box

	A	B	C	D	E	F	G	H	I	J	K	L	N
2	6	5	4	3	2	1							
3													
4	7	6	9	10	11	12							
5													
6	18	17	16	15	14	13							
7													
8	19	20	21	22	23	24							
9													
10	30	29	28	27	26	25							
11													
12	31	32	33	34	35	36							
13													

This corner was originally approved by the Kent County Remonumentation Peer Group and monumented by R. Jonker on 4/15/82 and was recorded per L.C.R.C. #2835.

B. Description of corner evidence found and/or method applied in restoring or reestablishing corner:

J-11 Found a Standard Kent County Monument 1.5' South of 100th Street (bit.) running East and West on a brush row running North as set by Rob Jonker in place of a 3/4" iron he found in a monument box which checked L.C.R.C. #1974 and K.C. Surveyor's records.

L.C.R.C. #2835

L.C.R.C. #7203

Remon. tag on SE side t. pole S 40° W 78.90'
 NW corner block bldg. S 60° W 142.45'


K.C. remon tag & nail in NE side P. pole N 45° W 78.90'
 NW corner of block building S 60° W 142.45'
 K.C. remon tag & nail in E side 10" Twin Elm (5' above grade) N 00° E 83.78'
 C/L MBT box S 45° W 60.87'
 NE corner of block building S 50° W 118.91'

The selected location is accepted by me and is generally accepted by professional surveyors as the best available evidence of the position of the original corner.

C. Description of monument for corner and accessories established to perpetuate locating the position of the corner:

J-11 Standard Kent County Monument

Nail & K.C. remon. tag on NE side P. pole N 45° W 78.90'
 NW corner of block building S 60° W 142.45'
 Nail & K.C. remon. tag on E side 10" Twin Elm (5' above grade) N 00° E 83.78'
 C/L MBT box S 45° W 60.87'
 NE corner of block building S 50° W 118.91'

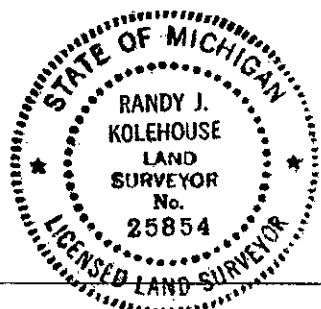

Signed by Randy J. Kolehouse

Date 7/23/96

Surveyor's Michigan License No. 25854