

SURVEY & REMONUMENTATION

FEB 14 1997

COMMISSION

LAND CORNER RECORDATION CERTIFICATE
Filing Requirement of Act 74, Mich. P.A. 1970
KENT COUNTY REMONUMENTATION

For corners in

Kent (County)	Located in: Gaines Township		Corner Code #
1. Public Land Survey	T <u>5N</u>	R <u>11W</u>	<u>K-2</u>
	T _____	R _____	_____
	T _____	R _____	_____
	T _____	R _____	_____
2. Property Controlling in Section	S _____	T _____	R _____
	S _____	T _____	R _____
3. Miscellaneous Property in Sec.	S _____	T _____	R _____
	S _____	T _____	R _____

STATE OF MICHIGAN
 COUNTY OF KENT
 RECEIVED FOR RECORD
 95 AUG -8 AM 8:46
 REG. OF DEEDS
Lucy Standa

9307

Register of Deeds Stamp & File Number

4. Lot No. _____, Recorded Plat _____
 5. Private Claims _____

A	B	C	D	E	F	G	H	I	J	K	L	M
2	6	5	4	3	2	1						
3												
4	7	6	5	4	3	2	1					
5												
6	18	17	16	15	14	13	12	11	10	9	8	7
7												
8	19	20	21	22	23	24	25	26	27	28	29	30
9												
10	31	32	33	34	35	36						
11												
12												
13												

I, Randy Kolehouse, in a field survey on December 28 19 95, do hereby certify that under requirements of P.A. 74 Michigan P.A. of 1970, the corner points mentioned in lines 1 and 2 above were in conformance with regulations and rules therefore as required in the current manual of survey instructions of the United States Department of the Interior, Bureau of Land Management or by a decree of a Court of Law and/or that the corner points mentioned in lines 3, 4 and 5 above were in conformance with the rules of the Michigan Board of Land Surveyors or by a Decree of a Court of Law; established, re-established, monumented, re-monumented, recovered, found as expressed below:

NOTE: Not more than 4 corners, all in the same town and range, may be recorded on this certificate.

A. Description of original monument and accessories and/or subsequent restoration:

K-2	1831	G.L.O. Notes	Mullet	Set Post
	1961	Witness Map	K.C. Surveyor	1/2" Iron in Mon. Box
	1973	L.C.R.C. #411	Medema, Van Kooten & Assoc.	3/4" Iron in Mon. Box
	1981	L.C.R.C. #2290	Nederveld & Jonker	Fnd. 1/2" Iron in Mon. Box / Set K.C. Monument
	1994	L.C.R.C. #7206	Glaza & Associates	K.C. Monument

P.A. 345 1990 KENT COUNTY

PEER APPROVED 3/7/96
 CHAIRMAN Harry Huber

This corner was originally approved by the Kent County Remonumentation Peer Group and monumented by Rob Jonker on 8/17/81 and was recorded per L.C.R.C. #2290.

B. Description of corner evidence found and/or method applied in restoring or reestablishing corner:

K-2 Found a Standard Kent County Monument 1.5' East of the C/L of East Paris Avenue (bit.) running North and South on line of a tree row running East & West per L.C.R.C.'s #2290 and #7206 as set by Nederveld & Jonker in place of a 1/2" iron in a monument box they found that checked L.C.R.C. #411 and K.C. Surveyor's records.

L.C.R.C. #2290

L.C.R.C. #7206

Nail & K.C. Remon. tag S side 14" Elm S 88° W 73.62'
 Centerline top North end 12" conc. culv. N 45° W 37.62'


Nail & K.C. remon tag in S side 16" Elm S 88° W 73.73' (m. 73.63')

The selected location is accepted by me and is generally accepted by professional surveyors as the best available evidence of the position of the original corner.

C. Description of monument for corner and accessories established to perpetuate locating the position of the corner:

K-2 Standard Kent County Monument

- Nail & K.C. remon. tag on SW side 12" Ash N 35° W 98.56'
- Nail & K.C. remon. tag on NE side 12" Ash N 50° W 116.79'
- Nail & K.C. remon. tag on S side P. pole N 90° E 54.65'
- Nail & K.C. remon. tag on S side 16" Elm S 88° W 73.63'

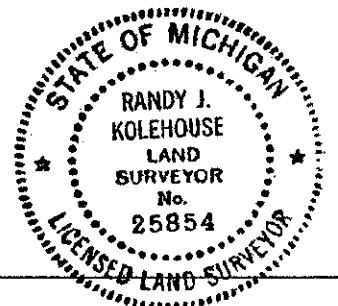

Signed by Randy J. Kolehouse
 EARTH TECH

Date 7/23/96

Surveyor's Michigan License No. 25854