

SURVEY & REMONUMENTATION

FEB 14 1997

LAND CORNER RECORDATION CERTIFICATE
Filing Requirement of Act 74, Mich. P.A. 1970
KENT COUNTY REMONUMENTATION

For corners in **COMMISSION**

Kent (County)	Located in:	Gaines Township	Corner Code #
1. Public Land Survey	T <u>5N</u>	R <u>11W</u>	<u>K-3</u>
	T _____	R _____	_____
	T _____	R _____	_____
	T _____	R _____	_____
2. Property Controlling in Section	S _____	T _____	R _____
	S _____	T _____	R _____
3. Miscellaneous Property in Sec.	S _____	T _____	R _____
	S _____	T _____	R _____

STATE OF MICHIGAN
COUNTY OF KENT
RECEIVED FOR RECORD

95 AUG -8 AM 8:46

REG. OF DEEDS

Lucy Stand


9308

Register of Deeds Stamp & File Number

4. Lot No. _____, Recorded Plat _____
 5. Private Claims _____

I, Randy Kolehouse, in a field survey on December 27 19 95, do hereby certify that under requirements of P.A. 74 Michigan P.A. of 1970, the corner points mentioned in lines 1 and 2 above were in conformance with regulations and rules therefore as required in the current manual of survey instructions of the United States Department of the Interior, Bureau of Land Management or by a decree of a Court of Law and/or that the corner points mentioned in lines 3, 4 and 5 above were in conformance with the rules of the Michigan Board of Land Surveyors or by a Decree of a Court of Law; established, re-established, monumented, re-monumented, recovered, found as expressed below:

NOTE: Not more than 4 corners, all in the same town and range, may be recorded on this certificate.

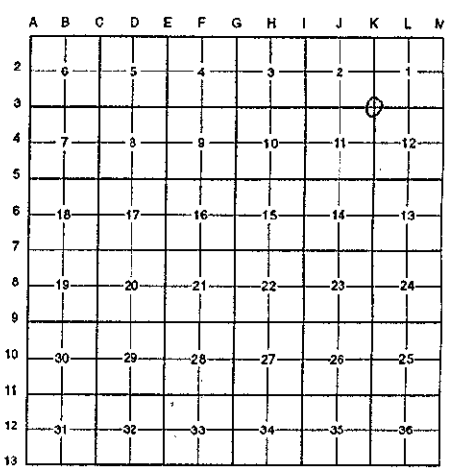

A. Description of original monument and accessories and/or subsequent restoration:

K-3	1831	G.L.O. Notes	Mullett	Set Post
	1960	Witness Map	K.C. Surveyor	"X" Cut in Pavement
	1973	L.C.R.C. #411	Medema, Van Kooten & Assoc.	5/8" Solid Iron
	1981	L.C.R.C. #2285	Nederveld Associates	Fnd. Capped Rerod / Set K.C. Monument
	1994	L.C.R.C. #7142	Glaza & Associates	Kent County Monument

P.A. 345 1990 KENT COUNTY
 PEER APPROVED 3/7/96
 CHAIRMAN Randy Kolehouse

This corner was originally approved by the Kent County Remonumentation Peer Group and monumented by Nederveld Associates on 8/17/81 and was recorded per L.C.R.C. #2285.

B. Description of corner evidence found and/or method applied in restoring or reestablishing corner:

K-3 Found a Standard Kent County Monument at the C/L intersection of 68th Street (bit.) running East and West and East Paris Avenue running North and South as set by Nederveld & Associates in place of a capped rerod they found that checked L.C.R.C. #411 and the K.C. Surveyor's records. All witnesses from L.C.R.C.'s #411, #2285 and #7142 have been destroyed.

The selected location is accepted by me and is generally accepted by professional surveyors as the best available evidence of the position of the original corner.

C. Description of monument for corner and accessories established to perpetuate locating the position of the corner:

- K-3 Standard Kent County Monument
- Nail & K.C. remon. tag on N side P. pole S 36° E 48.91'
 - Nail & K.C. remon. tag on NW side P. pole N 53° E 73.89'
 - Nail & K.C. remon. tag on NW side L. pole N 72° E 59.59'
 - Nail & K.C. remon. tag on N side P. pole S 77° W 110.95'
 - Nail & K.C. remon. tag on N side P. pole S 46° E 78.41'



Signed by Randy J. Kolehouse
 EARTH TECH

Date 7/23/96

Surveyor's Michigan License No. 25854